

NOTICE OF INTENTION TO DRILL

(see rules on reverse side)

Starting Date 12 01 87 month day year

API Number 15-065-22,429-00-00 50 N of E/2 E/2 E/2 33 Sec. 10 Twp. 10 S, Rg. 24 West 2690 Ft. from South Line of Section 330 Ft. from East Line of Section

OPERATOR: License # 7013 Name Geana Oil Company Address Route 1, Box 4 City/State/Zip Wakeeney, KS 67672 Contact Person Chuck Rhoades Phone 913-743-5419

(Note: Locate well on Section Plat on reverse side) Nearest lease or unit boundary line 330 feet County Graham Lease Name Pfeifer Well # 1 Ground surface elevation 2367 feet MSL Domestic well within 330 feet: yes no Municipal well within one mile: yes no

CONTRACTOR: License # 6033 Name Murfin Drilling Company City/State Wichita, KS

Well Drilled For: Well Class: Type Equipment: Oil SWD Infield Mud Rotary Gas Inj Pool Ext Air Rotary OWWO Expl Wildcat Cable

Depth to bottom of fresh water 100 Depth to bottom of usable water 1100 Surface pipe by Alternate 1 2 Surface pipe planned to be set 250 Conductor pipe required N/A Projected Total Depth 4250 feet Formation BKC

If OWWO: old well info as follows: Operator Well Name Comp Date Old Total Depth

I certify that well will comply with K.S.A. 55-101, et seq., plus eventually plugging hole to KCC specifications. Date 11-24-87 Signature of Operator or Agent Jack E. Coss, Agent for Operator Title Ass't. Drlg. Mgr.

For KCC Use: Conductor Pipe Required feet; Minimum Surface Pipe Required 200 feet per Alt. This Authorization Expires 5-24-88 Effective 11/29/87 Approved By R.H. 11-24-87


Must be filed with the K.C.C. five (5) days prior to commencing well  
 This card void if drilling not started within six (6) months of date received by K.C.C.

**Important procedures to follow:**

1. Notify District office before setting surface casing.
  2. Set surface casing by circulating cement to the top.
  3. File completion forms ACO-1 with K.C.C. within 90 days of well completion, following instructions on ACO-1, side 1, and including copies of wireline logs.
  4. Notify District office 48 hours prior to old well workover or re-entry.
  5. Prior to filing Intent, prepare a proposed plugging plan in case well is D & A, then obtain approval of plan when calling district office prior to setting surface pipe.
  6. Submit plugging report (CP-4) to K.C.C. after plugging is completed.
  7. Obtain an approved injection docket number before disposing of salt water.
- Notify K.C.C. within 10 days when injection commences or terminates.

If an alternate 2 completion, cement in the production pipe from below any usable water to surface within 120 days of spud date.

**A Regular Section of Land  
 1 Mile = 5,280 Ft.**

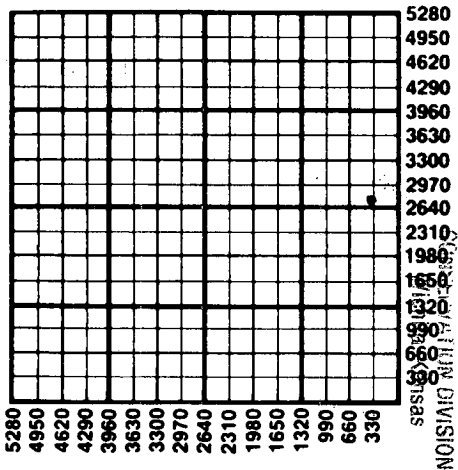

RECEIVED  
 STATE CORPORATION COMMISSION  
 11-24-87  
 NOV 24 1987

State Corporation Commission of Kansas  
 Conservation Division  
 200 Colorado Derby Building  
 Wichita, Kansas 67202  
 (316) 263-3238