

Give All Information Completely  
Make Required Affidavit  
Mail or Deliver Report to:  
Conservation Division  
State Corporation Commission  
212 No. Market  
Wichita, Kansas

WELL PLUGGING RECORD

GRAHAM

County. Sec. 11 Twp. 10S Rge. 24 (E) W (W)

Location as "NE/CNW/SW" or footage from lines E/2 E/2 SE/4

Lease Owner GEORGE A REED

Lease Name GANO #2 Well No. \_\_\_\_\_

Office Address 1223 UNION NATIONAL BLDG., WICHITA, KANSAS 67202

Character of Well (completed as Oil, Gas or Dry Hole) DRY HOLE

Date well completed DEC 20, 1969 19

Application for plugging filed DEC 20, 1969 19

Application for plugging approved DEC 20, 1969 19


Plugging commenced DEC 20, 1969 19

Plugging completed DEC 20, 1969 19

Reason for abandonment of well or producing formation TOO LOW STRUCTURALLY

If a producing well is abandoned, date of last production \_\_\_\_\_ 19

Was permission obtained from the Conservation Division or its agents before plugging was commenced? YES

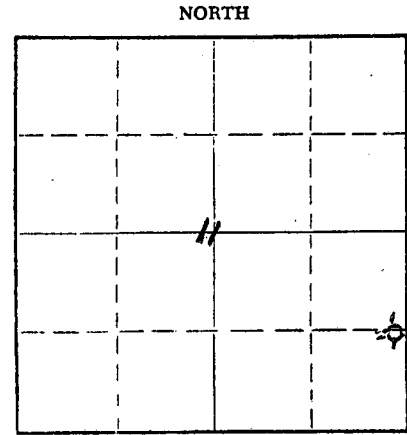

Locate well correctly on above Section Plat

Name of Conservation Agent who supervised plugging of this well W L NICHOLS, MORELAND, KS.

Producing formation \_\_\_\_\_ Depth to top \_\_\_\_\_ Bottom \_\_\_\_\_ Total Depth of Well 4060' Feet

Show depth and thickness of all water, oil and gas formations.

OIL, GAS OR WATER RECORDS

CASING RECORD

FORMATION	CONTENT	FROM	TO	SIZE	PUT IN	PULLED OUT
				8-5/8"	209.57'	NONE

Describe in detail the manner in which the well was plugged, indicating where the mud fluid was placed and the method or methods used in introducing it into the hole. If cement or other plugs were used, state the character of same and depth placed, from \_\_\_\_\_ feet to \_\_\_\_\_ feet for each plug set.

FILLED WITH HEAVY MUD TO 1150'. SET PLUG.  
PUT IN 100 SACKS CEMENT. FILLED WITH HEAVY  
MUD TO 215'. SET PLUG. PUT IN 25 SACKS  
CEMENT. FILLED WITH HEAVY MUD UP TO 440'.  
SET PLUG. FILLED TO TOP WITH 1 SACK HULLS  
AND 10 SACKS CEMENT.

RECEIVED  
STATE CORPORATION COMMISSION  
JAN 15 1970  
CONSERVATION DIVISION  
Wichita, Kansas  
01-15-1970

(If additional description is necessary, use BACK of this sheet)

Name of Plugging Contractor C-G DRILLING CO.

Address 1107 UNION NATIONAL BLDG., WICHITA, KANSAS 67202

STATE OF KANSAS, COUNTY OF SEDGWICK, ss.


G F GALLOWAY

(employee of owner) or (owner or operator) of the above-described well, being first duly sworn on oath, says: That I have knowledge of the facts, statements, and matters herein contained and the log of the above-described well as filed and that the same are true and correct. So help me God.

(Signature) G F GALLOWAY

1107 UNION NATIONAL BLDG.,  
(Address)

Subscribed and sworn to before me this 24th day of DEC., 19 69

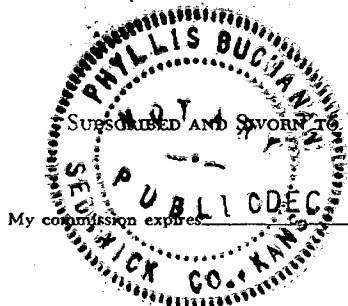

Phyllis Buchanan  
PHYLLIS BUCHANAN Notary Public.

