


STATE OF KANSAS
STATE CORPORATION COMMISSION

Give All Information Completely
Make Required Affidavit
Mail or Deliver Report to:
Conservation Division
State Corporation Commission
211 No. Broadway
Wichita, Kansas

15-065-~~2474~~⁰¹⁰⁴⁷⁴-00-00
WELL PLUGGING RECORD

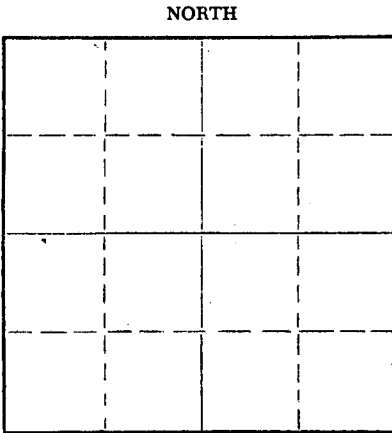

Locate well correctly on above
Section Plat

Graham County County. Sec. 30 Twp. 10S Rge. 25W (E) (W) X
Location as "NE/CNW%SW%" or footage from lines SW SW SE
Lease Owner Burch Drilling Co., Inc.
Lease Name Walsh Well No. 1
Office Address 1011 Union Center, Wichita, Kansas
Character of Well (completed as Oil, Gas or Dry Hole) Dry Hole
Date well completed 11-7-58 19
Application for plugging filed 11-7-58 19
Application for plugging approved 11-7-58 19
Plugging commenced 11-7-58 19
Plugging completed 11-7-58 19
Reason for abandonment of well or producing formation
Dry Hole
If a producing well is abandoned, date of last production 19
Was permission obtained from the Conservation Division or its agents before plugging was commenced? yes

Name of Conservation Agent who supervised plugging of this well A. D. Fabricus
Producing formation _____ Depth to top _____ Bottom _____ Total Depth of Well 4300 Feet
Show depth and thickness of all water, oil and gas formations.

OIL, GAS OR WATER RECORDS

CASING RECORD

FORMATION	CONTENT	FRDM	TD	SIZE	PUT IN	PULLED OUT

Describe in detail the manner in which the well was plugged, indicating where the mud fluid was placed and the method or methods used in introducing it into the hole. If cement or other plugs were used, state the character of same and depth placed, from _____ feet to _____ feet for each plug set.

1st plug set @ 600' w/ 20 sx. cement
2nd plug set @ 225' w/ 20 sx. cement
3rd plug set @ 40' w/ 10 sx. cement

RELEASED
STATE CORPORATION COMMISSION
DEC 3 - 1958
CONSERVATION DIVISION
Wichita, Kansas
12-03-1958

(If additional description is necessary, use BACK of this sheet)
Name of Plugging Contractor Burch Drilling Co., Inc.
Address 1011 Union Center, Wichita, Kansas

STATE OF KANSAS, COUNTY OF SEDGWICK, ss.
Earl M. Burch (employee or owner) or (owner or operator) of the above-described well, being first duly sworn on oath, says: That I have knowledge of the facts, statements, and matters herein contained and the log of the above-described well as filed and that the same are true and correct. So help me God.

(Signature) Earl M. Burch

(Address) _____

SUBSCRIBED AND SWORN TO before me this 2nd day of December, 1958

Ginny Harrison
Notary Public.



PLUGGING
FILE SEC. 30 T. 10 R. 25W
BOOK PAGE 149 LINE 6

15-065-00474-00-00

WELL LOG

BURCH DRILLING CO., INC.
1 WALSH
SW SW SE 30-10S-25W
Graham County, Kansas

8 5/8" set @ 221' w/125 sx.
ELEVATION: 2500' Kelly bushing
COMM: 10-30-58
COMP: 11-7-58
D & A

TOPS

60 Shale
1500 Shale & Shells
2146 Shale
2184 Anhydrite
2245 Shale
3907 Lime & Shale
4300 Lime

4300 Rotary Total Depth

HEEBNER 3786
TORONTO 3810
LANSING 3828
CHEROKEE LIME 4278

No Drill Stem Tests taken.

STATE OF KANSAS, COUNTY OF SEDGWICK:

I, Earl M. Burch, President of Burch Drilling Co., Inc. being duly sworn on oath, state: That I have knowledge of the facts, statements and matters herein contained and that the same are true and correct.



Subscribed and sworn to before me this 2nd day of December, 1958.


Notary Public

My commission expires: July 27, 1960.



DEC 3 - 1958
12-03-1958
CONSERVATION DIVISION
Wichita, Kansas

PLUGGING
FILE SEC 30 T 10 R 25W
BOOK PAGE 149 LINE 6