

This form shall be filed in duplicate with the Kansas Corporation Commission, 200 Colorado Derby Building, Wichita, Kansas 67202, within ten days after the completion of the well, regardless of how the well was completed.

Attach separate letter of request if the information is to be held confidential. If confidential, only file one copy. Information on side one will be of public record and side two will then be held confidential.

Circle one: Oil, Gas, Dry SWD, OWWO, Injection. Type and complete ALL sections. Applications must be filed for dual completion, commingling, SWD and injection, T.A.

Attach wireline logs (i.e. electrical log, sonic log, gamma ray neutron log, etc.). KCC # (316) 263-3238. (Rules 82-2-105 & 82-2-125)

OPERATOR ENERGY THREE, INC.

API NO. 15-065-21,598-00-00

ADDRESS P. O. Box 1505 GREAT BEND, KANSAS 67530

COUNTY GRAHAM

**CONTACT PERSON R. D. STANDLEE

FIELD

PHONE AC 316-792-5968

PROD. FORMATION

PURCHASER

LEASE GRIFFITH

ADDRESS

WELL NO. 1

WELL LOCATION CENT. W/2 SW NE

DRILLING CONTRACTOR BIG THREE DRILLING, INC.

330 Ft. from WEST Line and

ADDRESS P. O. Box 52

660 Ft. from SOUTH Line of


GORHAM, KANSAS 67640

the NE/4 SEC. 5 TWP. 10S RGE. 22W

PLUGGING CONTRACTOR SUN OILWELL CEMENTING Co.

WELL PLAT

ADDRESS GREAT BEND, KANSAS

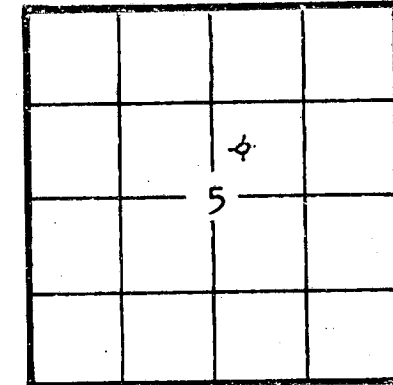

KCC (checked) KGS (checked) (Office Use)

TOTAL DEPTH 3910 PBDT

SPUD DATE 6-2-82 DATE COMPLETED 6-12-82

ELEV: GR 2308 DF KB 2313

DRILLED WITH (CABLE) (ROTARY) (AIR) TOOLS

Amount of surface pipe set and cemented 262' DV Tool Used? No

AFFIDAVIT

STATE OF KANSAS, COUNTY OF GRAHAM SS, I,

R. D. STANDLEE OF LAWFUL AGE, BEING FIRST DULY SWORN UPON HIS OATH,

DEPOSES THAT HE IS EXECUTIVE VICE-PRES. (FOR) (OF) ENERGY THREE, INC.

OPERATOR OF THE GRIFFITH LEASE, AND IS DULY AUTHORIZED TO MAKE

THIS AFFIDAVIT FOR AND ON THE BEHALF OF SAID OPERATOR, THAT WELL NO. 1 ON

SAID LEASE HAS BEEN COMPLETED AS OF THE 12TH DAY OF JUNE, 19 82, AND THAT

ALL INFORMATION ENTERED HEREIN WITH RESPECT TO SAID WELL IS TRUE AND CORRECT.

FURTHER AFFIANT SAYS THAT... JUN 25 1982 CONSERVATION DIVISION Wichita, Kansas

(S) [Signature]

SUBSCRIBED AND SWORN BEFORE ME THIS 23RD DAY OF JUNE, 19 82

HOWARD D. EWERT Barton County, Ks. My Appt. Exp. 12-15-84

[Signature] NOTARY PUBLIC HOWARD D. EWERT

MY COMMISSION EXPIRES: DECEMBER 15, 1984

**The person who can be reached by phone regarding any questions concerning this information. Within 45 days of completion, a witnessed initial test by the Commission is required if the well produces more than 25 BOPD or is located in a Basic Order Pool.

SIDE TWO

WELL LOG

SHOW GEOLOGICAL MARKERS, LOGS RUN, OR OTHER DESCRIPTIVE INFORMATION.

Show all important zones of porosity and contents thereof; cored intervals, and all drill-stem tests, including depth interval tested, cushion used, time tool open, flowing and shut-in pressures, and recoveries.

FORMATION DESCRIPTION; CONTENTS, ETC.	TOP	BOTTOM	NAME	DEPTH
SAND & SHALE	-0-	1305	GREAT GUNS RAN OPEN HOLE LOG FROM 3910' TO -0- 6-11-82	
SHALE & SAND	1305	1835		
ANHYDRITE	1835	1878		
SHALE & SAND	1878	2139		
LIME & SHALE	2139	3858		
LIME	3858	3910		
		RTD	FORMATION TOPS:	
			HEEBNER	3537
			TORONTO	3560
			LANS.-KC	3573
			BASE KC	3795
			MARMATON	
			CHERT	3883

Report of all strings set — surface, intermediate, production, etc. **CASING RECORD** (New) or (Used)

Purpose of string	Size hole drilled	Size casing set (in O.D.)	Weight lbs/ft.	Setting depth	Type cement	Sacks	Type and percent additives
SURFACE	12 1/4	8 5/8	20 #	262	COMMON	200	3 % C.C. 2 % GEL.

LINER RECORD

PERFORATION RECORD

Top, ft.	Bottom, ft.	Sacks cement	Shots per ft.	Size & type	Depth interval

TUBING RECORD		
Size	Setting depth	Packer set at

ACID, FRACTURE, SHOT, CEMENT SQUEEZE RECORD

Amount and kind of material used	Depth interval treated


Date of first production	Producing method (flowing, pumping, gas lift, etc.)	Gravity
DRY HOLE		
RATE OF PRODUCTION PER 24 HOURS	Oil bbls.	Gas MCF
	Water %	Gas-oil ratio CFPB
Disposition of gas (vented, used on lease or sold)		Perforations