

CARD MUST BE TYPED

NOTICE OF INTENTION TO DRILL

State of Kansas
(see rules on reverse side)

CARD MUST BE SIGNED

Starting Date: 10 4 84
month day year

API Number 15- 065-20,198-400-01

OPERATOR: License # 8714

N/2. N/2 SW Sec 7... Twp 10 S, Rge 24W. East West
(location)

Name T-L Energy Company

Address St. Peter Route

City/State/Zip Morland, KS 67650

Contact Person Lloyd Pfeifer

Phone (913) 627-5711

2310 Ft North from Southeast Corner of Section
3960 Ft West from Southeast Corner of Section
(Note: Locate well on Section Plat on reverse side)

CONTRACTOR: License # 5135

Name John O. Farmer, Inc.

City/State Russell, KS 67665

Nearest lease or unit boundary line 330 feet.

County Graham

Lease Name Dan Richmeier #2 Well# ~~1100~~ 2

Domestic well within 330 feet: yes no

Municipal well within one mile: yes no

Well Drilled For: Well Class: Type Equipment:

Oil Swd Infield Mud Rotary

Gas Inj Pool Ext. Air Rotary

OWWO Expl Wildcat Cable

Depth to Bottom of fresh water 80 feet

Lowest usable water formation Dakota

Depth to Bottom of usable water 1100 / 1300 feet

Surface pipe by Alternate: 1 2

Surface pipe ~~to be~~ set 157' feet

Conductor pipe if any required none feet

Ground surface elevation 2436 feet MSL

This Authorization Expires 3-22-85

Approved By 9-28-84 R

If OWWO: old well info as follows:

Operator Empire Drilling Company

Well Name Dan Richmeier #2

Comp Date 2-13-69 Old Total Depth 3944'

Projected Total Depth 4000 feet

Projected Formation at TD Base Lansing/KC

Expected Producing Formations Base Lansing/KC

I certify that we will comply with K.S.A. 55-101, et seq., plus eventually plugging hole to K.C.C. specifications.

Date Sept 26-84 Signature of Operator or Agent

Lloyd J Pfeifer Title Manager


mhc/udhe 9/28/84 Form C-1 4/84

Must be filed with the K.C.C. five (5) days prior to commencing well
This card void if drilling not started within six (6) months of date received by K.C.C.

Important procedures to follow :

A Regular Section of Land

1 Mile = 5,280 Ft.

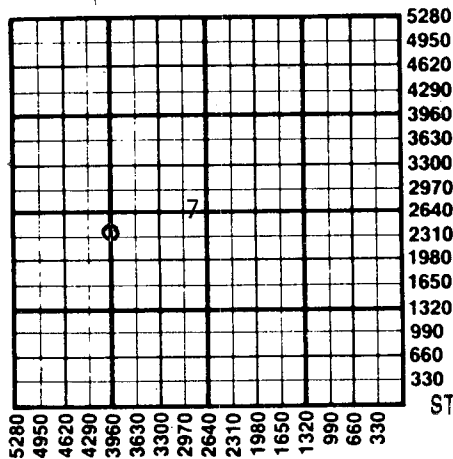

1. Notify District office before setting surface casing.
2. Set surface casing by circulating cement to the top.
3. File completion forms ACO-1 with K.C.C. within 90 days of well completion, following instructions on ACO-1, side 1, and including copies of wireline logs.
4. Notify District office 48 hours prior to old well workover or re-entry.
5. Prior to plugging, prepare a plugging plan, then obtain agreement from the appropriate district office for an approved plugging plan.
6. Submit plugging report (CP-4) to K.C.C. after plugging is completed.
7. Obtain an approved injection docket number before disposing of salt water.
8. Notify K.C.C. within 10 days when injection commences or terminates.
9. If an alternate 2 completion, cement in the production pipe from below any usable water to surface within 120 days of spud date.

RECEIVED
STATE CORPORATION COMMISSION

SEP 28 1984
09-28-1984
CONSERVATION DIVISION
Wichita, Kansas

State Corporation Commission of Kansas
Conservation Division
200 Colorado Derby Building
Wichita, Kansas 67202
(316)263-3238