

CARD MUST BE TYPED

State of Kansas
NOTICE OF INTENTION TO DRILL
(see rules on reverse side)

CARD MUST BE SIGNED

Starting Date: July 1, 1985
month day year

API Number 15- 065-22,204-00-00

OPERATOR: License # 8714
Name T-L Energy Company
Address St. Peter Route
City/State/Zip Morland, KS 67650
Contact Person Lloyd J. Pfeifer
Phone 913-627-5711

c S1/2-SW-NW Sec 7 Twp 10 S, Rge 24
(location) East West

2970 Ft North from Southeast Corner of Section
4620 Ft West from Southeast Corner of Section
(Note: Locate well on Section Plat on reverse side)

CONTRACTOR: License #
Name Unknown
City/State

Nearest lease or unit boundary line 330 feet

County Graham

Lease Name Riedel Well# 1

Well Drilled For: Well Class: Type Equipment:
 Oil Swd Infield Mud Rotary
 Gas Inj Pool Ext. Air Rotary
 OWWO Expl Wildcat Cable

Domestic well within 330 feet: yes no
Municipal well within one mile: yes no

If OWWO: old well info as follows:

Operator
Well Name
Comp Date Old Total Depth
Projected Total Depth 4000 feet
Projected Formation at TD Base Lansing/KC
Expected Producing Formations Base Lansing/KC

Depth to Bottom of fresh water 80 feet

Lowest usable water formation Dakota

Depth to Bottom of usable water 1100 1300 feet

Surface pipe by Alternate: 1 2

Surface pipe to be set ~~Asphalt~~ 200 feet

Conductor pipe if any required None feet

Ground surface elevation 2454 feet MSL

This Authorization Expires 12-13-85

Approved By 6-13-85

I certify that we will comply with K.S.A. 55-101, et seq., plus eventually plugging hole to K.C.C. specifications.

Date 6-11-85 Signature of Operator or Agent

Lloyd J. Pfeifer


Title

MHC/MOHE 6-13-85
Production Mngr.

**Must be filed with the K.C.C. five (5) days prior to commencing well
This card void if drilling not started within six (6) months of date received by K.C.C.**

Important procedures to follow :

**A Regular Section of Land
1 Mile = 5,280 Ft.**

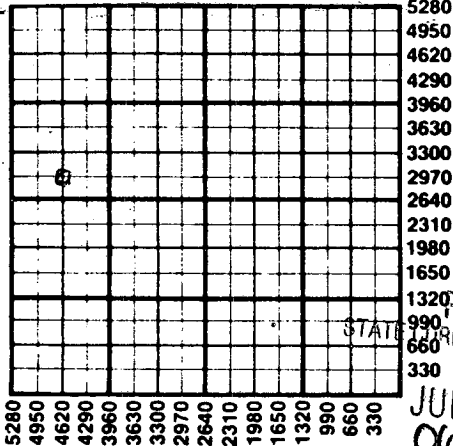

1. Notify District office before setting surface casing.
 2. Set surface casing by circulating cement to the top.
 3. File completion forms ACO-1 with K.C.C. within 90 days of well completion, following instructions on ACO-1, side I, and including copies of wireline logs.
 4. Notify District office 48 hours prior to old well workover or re-entry.
 5. Prior to plugging, prepare a plugging plan, then obtain agreement from the appropriate district office for an approved plugging plan.
 6. Submit plugging report (CP-4) to K.C.C. after plugging is completed.
 7. Obtain an approved injection docket number before disposing of salt water.
8. Notify K.C.C. within 10 days when injection commences or terminates.
Alternate 2 completion, cement in the production pipe from below any usable water to surface within 120 days of spud date.

RECEIVED
STATE CORPORATION COMMISSION
WICHITA, KANSAS

JUN 13 1985
06-13-1985
CONSERVATION DIVISION
Wichita, Kansas

**State Corporation Commission of Kansas
Conservation Division
200 Colorado Derby Building
Wichita, Kansas 67202
(316) 263-3238**