

NOTICE OF INTENTION TO DRILL

(see rules on reverse side)

Expected Spud Date... February 20, 1988
month day year

API Number 15-179-20, 918-00-00 ✓
NE. SW. NW. Sec. 1 Twp. 10 S, Rg. 26
3630 Ft. from South Line of Section
4290 Ft. from East Line of Section

OPERATOR: License # 5063
Name Energy Exploration, Inc.
Address 1002 S. Broadway
City/State/Zip Wichita, Ks. 67211
Contact Person Kevin Howard
Phone 316/267-7336

(Note: Locate well on Section Plat on reverse side)
Nearest lease or unit boundary line 990 feet
County Sheridan

CONTRACTOR: License # 5107
Name H-30 Drilling, Inc.
City/State 251 N. Water, Wichita, Ks. 67202

Lease Name Lang Well # 1
Ground surface elevation approx. 2570 feet MSL
Domestic well within 330 feet: yes X no
Municipal well within one mile: yes X no

Well Drilled For: Well Class: Type Equipment:
X Oil Storage Infield X Mud Rotary
Gas Inj Pool Ext Air Rotary
OWWO Expl X Wildcat Cable

Depth to bottom of fresh water 100'
Depth to bottom of usable water 1310'
Surface pipe by Alternate: 1 2 X
Surface pipe planned to be set 200'
Conductor pipe required none
Projected Total Depth 4100 feet
Formation Marmaton

If OWWO: old well info as follows:
Operator
Well Name
Comp Date Old Total Depth


I certify that well will comply with K.S.A. 55-101, et seq., plus eventually plugging hole to KCC specifications.
Date 2-18-88 Signature of Operator or Agent Title President

For KCC Use:
Conductor Pipe Required feet; Minimum Surface Pipe Required 200 feet per Alt. X 2
This Authorization Expires 8-19-88 Approved By 2-19-88

EFFECTIVE DATE: 2-24-88

Must be filed with the K.C.C. five (5) days prior to commencing well
This card void if drilling not started within six (6) months of date received by K.C.C.

A Regular Section of Land
1 Mile = 5,280 Ft.

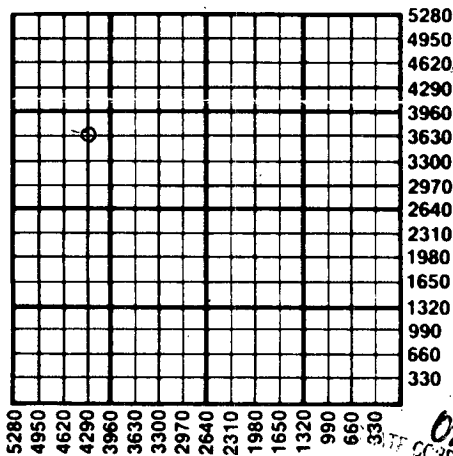

Important procedures to follow:

1. Notify District office before setting surface casing.
2. Set surface casing by circulating cement to the top.
3. File completion forms ACO-1 with K.C.C. within 120 days of well spud date, following instructions on ACO-1, side 1, and including copies of wireline logs.
4. Notify District office 48 hours prior to old well workover or re-entry.
5. Prior to filing Intent, prepare a proposed plugging plan in case well is D & A, then obtain approval of plan when calling district office prior to setting surface pipe.
6. Submit plugging report (CP-4) to K.C.C. after plugging is completed.
7. Obtain an approved injection docket number before disposing of salt water.
8. Notify K.C.C. within 10 days when injection commences or terminates.
9. If an alternate 2 completion, cement in the production pipe from below any usable water to surface within 120 days of spud date.

02-19-1988
STATE CORPORATION COMMISSION
FEB 19 1988
CONSERVATION DIVISION
Wichita, Kansas

State Corporation Commission of Kansas
Conservation Division
200 Colorado Derby Building
Wichita, Kansas 67202-1212
(316) 263-3238