

CARD MUST BE TYPED

State of Kansas
NOTICE OF INTENTION TO DRILL
(see rules on reverse side)

CARD MUST BE SIGNED

Starting Date: June 1, 1985
month day year

API Number 15- 179-20,814-00-00

OPERATOR: License # 5205
Name Mid-Continent Energy Corp.
Address 120 S. Market, Suite 310
City/State/Zip Wichita, KS 67202
Contact Person Bradley R. Buehler
Phone 316-265-9501

..... SW. NE. SE $\frac{1}{4}$ Sec. 1. Twp. 10 S, Rge. 26. East
(location) West

..... 1650... Ft North from Southeast Corner of Section
..... 990... Ft West from Southeast Corner of Section
(Note: Locate well on Section Plat on reverse side)

CONTRACTOR: License # 5418
Name Allen Drilling Company
City/State Great Bend, KS 67530

Nearest lease or unit boundary line 990 feet.
County SHERIDAN
Lease Name MICKY Well# 1

Domestic well within 330 feet : yes no
Municipal well within one mile : yes no

Well Drilled For: **Well Class:** **Type Equipment:**
 Oil Swd Infield Mud Rotary
 Gas Inj Pool Ext. Air Rotary
 OWWO Expl Wildcat Cable

Depth to Bottom of fresh water 100 feet
Lowest usable water formation Dakota feet
Depth to Bottom of usable water 132.5 feet
Surface pipe by Alternate : 1 2

If OWWO: old well info as follows:
Operator
Well Name
Comp Date Old Total Depth
Projected Total Depth 4100 feet
Projected Formation at TD Lansing
Expected Producing Formations Lansing

Surface pipe to be set 250 feet
Conductor pipe if any required feet
Ground surface elevation feet MSL
This Authorization Expires 11-5-85
Approved By 5-6-85 [Signature]

I certify that we will comply with K.S.A. 55-101, et seq., plus eventually plugging hole to K.C.C. specifications.

Date 5/1/85 Signature of Operator or Agent [Signature] Title [Signature]
Form C-1 4/84


MHC/MOHE 5-6-85

Must be filed with the K.C.C. five (5) days prior to commencing well
 This card void if drilling not started within six (6) months of date received by K.C.C.

A Regular Section of Land
1 Mile = 5,280 Ft.

RECEIVED
 STATE CORPORATION COMMISSION
 05-06-1985
 MAY 06 1985

Important procedures to follow :

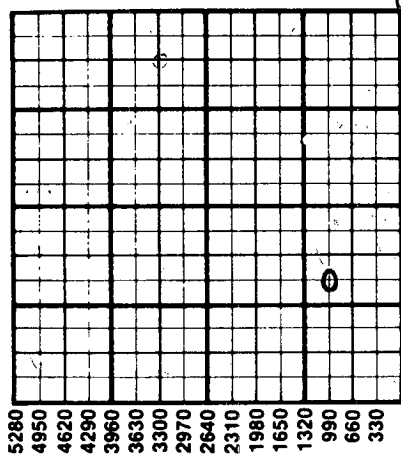

CONSERVATION DIVISION
 Wichita, Kansas

1. Notify District office before setting surface casing.
2. Set surface casing by circulating cement to the top.
3. File completion forms ACO-1 with K.C.C. within 90 days of well completion, following instructions on ACO-1, side 1, and including copies of wireline logs.
4. Notify District office 48 hours prior to old well workover or re-entry.
5. Prior to plugging, prepare a plugging plan, then obtain agreement from the appropriate district office for an approved plugging plan.
6. Submit plugging report (CP-4) to K.C.C. after plugging is completed.
7. Obtain an approved injection docket number before disposing of salt water.
8. Notify K.C.C. within 10 days when injection commences or terminates.
9. If an alternate 2 completion, cement in the production pipe from below any usable water to surface within 120 days of spud date.

State Corporation Commission of Kansas
Conservation Division
200 Colorado Derby Building
Wichita, Kansas 67202
(316) 263-3238