

15-065-21533-0000


STATE OF KANSAS  
STATE CORPORATION COMMISSION

WELL PLUGGING RECORD

Give All Information Completely  
Make Required Affidavit  
Mail or Deliver Report to  
Conservation Division  
State Corporation Comm.  
245 North Water  
Wichita, KS 67202

Graham County, Sec. 28 Twp. 10S Rge. 22 ~~SE~~W  
Location as "NE/CNW 1/4 SW 1/4" or footage from lines  
SW NW NE

Lease Owner Rains & Williamson Oil Co., Inc.  
Lease Name Faulkner Well No. #1  
Office Address 435 Page Court, 220 W. Douglas, Wichita, Ks.  
Character of Well (Completed as Oil, Gas or Dry Hole) Dry Hole

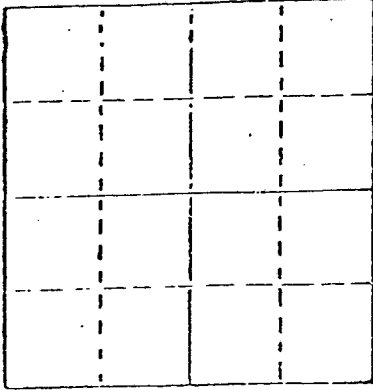

Locate well correctly on above  
Section Plat

Date Well completed 1-23-82 1982  
Application for plugging filed 1-22-82 1982  
Application for plugging approved 1-22-82 1982  
Plugging commenced 1-22-82 1982  
Plugging completed 1-23-82 1982

Reason for abandonment of well or producing formation  
Commercial quantities of oil not found  
If a producing well is abandoned, date of last production  
1982

Was permission obtained from the Conservation Division or  
its agents before plugging was commenced? Yes

Name of Conservation Agent who supervised plugging of this well Dennis Hamil  
Producing formation \_\_\_\_\_ Depth to top \_\_\_\_\_ Bottom \_\_\_\_\_ Total Depth of Well 3810'  
Show depth and thickness of all water, oil and gas formations.

OIL, GAS OR WATER RECORDS

CASING RECORD

FORMATION	CONTENT	FROM	TO	SIZE	PUT IN	PULLED OUT
				8 5/8"	246'	None

Describe in detail the manner in which the well was plugged, indicating where the mud fluid  
was placed and the method or methods used in introducing it into the hold. If cement or other  
plugs were used, state the character of same and depth placed, from \_\_\_\_\_ feet to  
\_\_\_\_\_ feet for each plug set.

Plug @ 900' w/70 sx.  
Plug @ 250' w/40 sx.  
Plug @ 40' w/10 sx.  
Rat Hole 10 sx.

RECEIVED  
STATE CORPORATION COMMISSION  
02-12-1982  
FEB 12 1982  
CONSERVATION DIVISION  
Wichita, Kansas

(If additional description is necessary, use BACK of this sheet)

Name of Plugging Contractor Rains & Williamson Oil Co., Inc.

STATE OF Kansas COUNTY OF Sedgwick, ss.

Wilson Rains, President of Rains & Williamson Oil Co. (employee of owner) or (owner or operator)  
of the above-described well, being first duly sworn on oath, says: That I have knowledge of  
the facts, statements, and matters herein contained and the log of the above-described well  
as filed and that the same are true and correct. So help me God.

(Signature) Wilson Rains

435 Page Court, 220 W. Douglas, Wichita, Ks. 67202  
(Address)

SUBSCRIBED AND SWORN TO before me this 8 day of February, 1982.



10-4-83

Juanita M. Green  
Notary Public.

15-065 - 21533 - 00 - 00

DRILLER'S LOG

COMPANY: Rains & Williamson Oil Co., Inc.

SEC. 28 T. 10S R. 22W

WELL NAME: Faulkner #1

LOC. SW NW NE

RIG NO. #4

COUNTY: Graham

TOTAL DEPTH 3810'

ELEVATION 2280 GL 2285 KB

COMMENCED: 1-9-82

COMPLETED: 1-23-82

CONTRACTOR: Rains & Williamson Oil Co., Inc.

CASING RECORD:

SURFACE: 8 5/8" @ 246' w/165 sx. 60/40 poz., 2% gel, 3% cc.

PRODUCTION: D&A

LOG

(Figures Indicate Bottom of Formations)

Shale	1075
Shale & Sand	1545
Shale	2420
Lime & Shale	2925
Shale	3175
Shale & Lime	3310
Lime	3405
Lime & Shale	3455
Lime	3625
Lime & Shale	3733
Lime	3810
<u>ROTARY TOTAL DEPTH</u>	<u>3810</u>

RECEIVED  
 STATE CORPORATION COMMISSION  
 FEB 12 1982  
 02-12-1982  
 CONSERVATION DIVISION  
 Wichita, Kansas


STATE OF Kansas )

COUNTY OF Sedgwick )

SS:

I, Wilson Rains, President of Rains & Williamson Oil Co., Inc.  
 upon oath state that the above and foregoing is a true and correct copy of the log of the  
Faulkner #1 well.

Wilson Rains  
 Wilson Rains

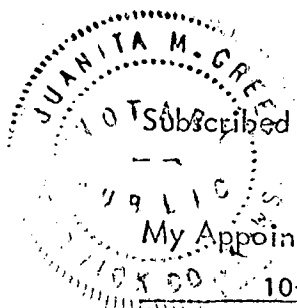

Subscribed and sworn to before me this 8 day of February, 1982.

Juanita M. Green  
 Juanita M. Green