


STATE OF KANSAS
STATE CORPORATION COMMISSION

WELL PLUGGING RECORD

Give All Information Completely
Make Required Affidavit
Mail or Deliver Report to:
Conservation Division
State Corporation Commission
314 No. Broadway P.O. Bx. 17027
Wichita, Kansas 67217
NORTH

Graham County. Sec. 28 Twp. 10S Rge. (E) 22 (W)
Location as "NE/CNW/SW" or footage from lines c NE NE
Lease Owner F & M Oil Co., Inc.
Lease Name Faulkner Well No. 1
Office Address 603 Union Center Bldg., Wichita, Kansas 67202
Character of Well (completed as Oil, Gas or Dry Hole) Dry Hole
Date well completed May 22 19 72
Application for plugging filed May 22 19 72
Application for plugging approved May 22 19 72
Plugging commenced May 22 19 72
Plugging completed May 22 19 72
Reason for abandonment of well or producing formation Dry Hole

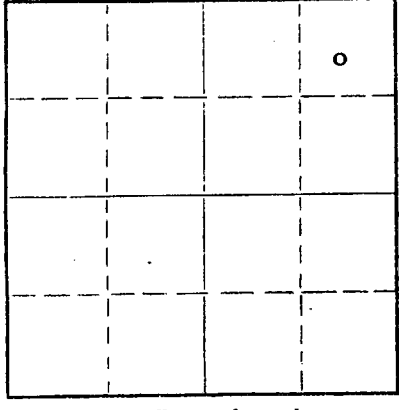

Locate well correctly on above
Section Plat

If a producing well is abandoned, date of last production 19
Was permission obtained from the Conservation Division or its agents before plugging was commenced? Yes

Name of Conservation Agent who supervised plugging of this well W. L. Nichols, Morland, Kansas
Producing formation _____ Depth to top _____ Bottom _____ Total Depth of Well 3810 Feet
Show depth and thickness of all water, oil and gas formations.

OIL, GAS OR WATER RECORDS

CASING RECORD

FORMATION	CONTENT	FROM	TO	SIZE	PUT IN	PULLED OUT
		0	211'	8 5/8"	211'	None

Describe in detail the manner in which the well was plugged, indicating where the mud fluid was placed and the method or methods used in introducing it into the hole. If cement or other plugs were used, state the character of same and depth placed, from _____ feet to _____ feet for each plug set.

Plug: 900' w/70 sacks cement
245' w/30 sacks cement
40' w/10 sacks cement


RECEIVED
STATE CORPORATION COMMISSION
MAY 25 1972
15-25-1972
CONSERVATION DIVISION
Wichita, Kansas

(If additional description is necessary, use BACK of this sheet)

Name of Plugging Contractor Hellar Drilling Company, Inc.
Address 339 Union Center Bldg., Wichita, Kansas 67202

STATE OF Kansas, COUNTY OF Sedgwick, ss.
D. L. Hellar, President of Hellar Drlg. Co. Inc. (employee of owner) or (owner or operator) of the above-described well, being first duly sworn on oath, says: That I have knowledge of the facts, statements, and matters herein contained and the log of the above-described well as filed and that the same are true and correct. So help me God.

(Signature) D. L. Hellar D. L. Hellar, President
339 Union Center Bldg., Wichita, Kansas 67202
(Address)

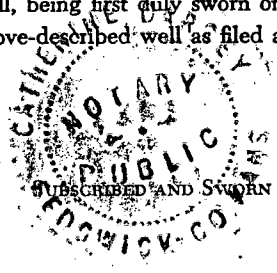

Subscribed and Sworn to before me this 24th day of May, 19 72
Catherine Darcey Notary Public.

My commission expires March 25, 1976.

15-065-20547-00-00

DRILLER'S LOG

COMPANY: F & M Oil Co., Inc., 603 Union Center Bldg., Wichita, Kansas 67202
 CONTRACTOR: Hellar Drilling Company, Inc., 339 Union Center Bldg., Wichita, Ks.67202
 LEASE: #1 Faulkner
 LOCATION: c NE NE 28-10S-22W, Graham County, Kansas
 COMMENCED: May 14, 1972
 COMPLETED: May 22, 1972
 CASING: Set 8 5/8" Surface Casing @ 211' w/150 sacks cement

0-211	Surface Soil-Post Rock & Shale
211-515	Shale & Sand
515-1170	Shale w/Hard Streaks Sand - Shale
1170-1805	Shale-Shells-Sand & Red Bed
1805-1848	Anhydrite
1848-2088	Shale
2088-2275	Shale w/Lime Streaks
2275-3575	Lime & Shale
3575-3810	Lime
3810	Rotary Total Depth

D & A

RECEIVED
 STATE CORPORATION COMMISSION
 MAY 25 1972
 05-25-1972
 CONSERVATION DIVISION
 Wichita, Kansas

STATE OF KANSAS)
) SS
 COUNTY OF SEDGWICK)

I, D. L. Hellar, do hereby certify that the above and foregoing is a true and correct copy of the log of the #1 Faulkner, located in c NE NE 28-10S-22W, Graham County, Kansas, as reflected by the files of the Hellar Drilling Company, Inc.

HELLAR DRILLING COMPANY, INC.

By *D. L. Hellar*
 President - D. L. Hellar

Subscribed and sworn to before me, a Notary Public, in and for Sedgwick County, Kansas, this 24th day of May, 1972.



Catherine Darcey
 Notary Public - Catherine Darcey

My Commission Expires:
 March 25, 1976.