


15-065-20787-00-00

FORM CP-4

STATE OF KANSAS
STATE CORPORATION COMMISSION
CONSERVATION DIVISION
P. O. BOX 17027
WICHITA, KANSAS 67217

WELL PLUGGING RECORD

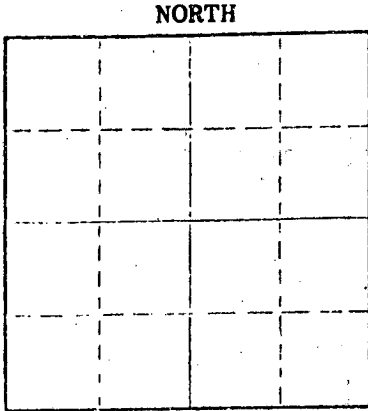

Locate well correctly on above Section Plat

Graham County, Sec. 29 Twp. 10S Rge. 22 (W)
Location as "NE/CNW/SW" or footage from lines: N/2 SE NE
Lease Owner: A. Scott Ritchie
Lease Name: Fritts Well No. 1
Office Address: 412 Union Center, Wichita, Ks 67202
Character of Well (completed as Oil, Gas or Dry Hole): Dry Hole
Date well completed: 11/11 1975
Application for plugging filed: 11/11 1975
Application for plugging approved: 11/11 1975
Plugging commenced: 11/11 1975
Plugging completed: 11/11 1975
Reason for abandonment of well or producing formation: Dry Hole

If a producing well is abandoned, date of last production: 19
Was permission obtained from the Conservation Division or its agents before plugging was commenced? Yes

Name of Conservation Agent who supervised plugging of this well: Gilbert Balthezor
Producing formation: _____ Depth to top: _____ Bottom: _____ Total Depth of Well: 3638 Feet
Show depth and thickness of all water, oil and gas formations.

OIL, GAS OR WATER RECORDS				CASING RECORD		
FORMATION	CONTENT	FROM	TO	SIZE	PUT IN	PULLED OUT
				8 5/8"	172'	None

Describe in detail the manner in which the well was plugged, indicating where the mud fluid was placed and the method or methods used in introducing it into the hole. If cement or other plugs were used, state the character of same and depth placed, from _____ feet to _____ feet for each plug set.

1st plug @ 900' w/70 sx
2nd plug @ 170' w/20 sx
3rd plug @ 40' w/10 sx

RECEIVED
STATE CORPORATION COMMISSION

NOV 17 1975
11-17-75
CONSERVATION DIVISION
Wichita, Kansas

(If additional description is necessary, use BACK of this sheet)
Name of Plugging Contractor: Allied Cmtg
Address: Box 31, Russell, Kansas 67665

STATE OF Kansas COUNTY OF Sedgwick ss.
James R. Daniels (employee of owner) of the above-described

well, being first duly sworn on oath, says: That I have knowledge of the facts, statements, and matters herein contained and the log of the above-described well as filed and that the same are true and correct. So help me God.

(Signature) James R. Daniels
617 Union Center, Wichita, Ks 67202 (Address)

SUBSCRIBED AND SWORN TO before me this 14th day of November, 1975

JOLENE S. FRISBIE, STATE NOTARY PUBLIC
My Comm. Exp. March 13, 1979
Jolene S. Frisbie Notary Public.



WELL LOG

15-D65-20787-00-00

COMPANY A. Scott Ritchie

SEC. 29 T. 10S R. 22W
LOC. N/2 SE NE

FARM FRITTS

NO. 1


RIG. NO. 15

TOTAL DEPTH 3638'

COUNTY Graham
KANSAS

COMM. 11/6/75

COMP. 11/11/75

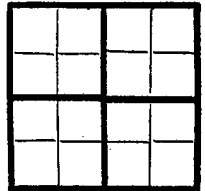

CONTRACTOR Murfin Drilling

CASING

20 10
15 8 5/8" @ 172' w/140 sx
12 6
13 5

ELEVATION

PRODUCTION D&A

FIGURES INDICATE BOTTOM OF FORMATIONS

- 40 - surf clay
- 150 - sand, shale
- 172 - blue shale
- 525 - cmt, shale
- 1340 - shale, blue
- 1565 - sand
- 1610 - shale (red bed)
- 1839 - red bed
- 1875 - anhydrite
- 2350 - shale
- 3530 - shale, lime
- 3638 - lime
- 3638 - TD

RECEIVED
STATE CORPORATION COMMISSION
NOV 17 1975
11-17-1975
CONSERVATION DIVISION
Wichita, Kansas

State of Kansas }
County of Sedgwick } ss:

I, James R. Daniels of the Murfin Drilling Company

upon oath state that the above and foregoing is a true and correct copy of the log of the Fritts #1 well.



Subscribed and sworn to before me this 14th day of November 19 75

JOLENE S. FRISBIE, STATE NOTARY PUBLIC
My Comm. Exp. March 13, 1979

James R. Daniels
Jolene S. Frisbie
NOTARY PUBLIC