


WELL PLUGGING RECORD

Give All Information Completely
Make Required Affidavit
Mail or Deliver Report to:
Conservation Division
State Corporation Commission
211 No. Broadway
Wichita, Kansas

NORTH

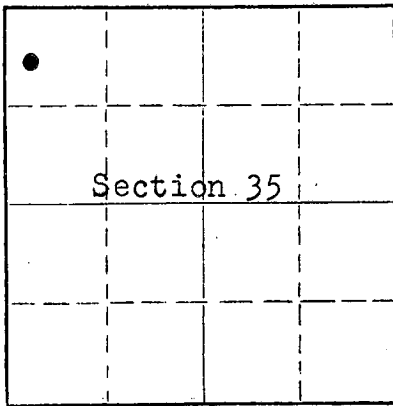

Locate well correctly on above Section Plat

Graham County, Sec 35 Twp 10 Rge. 22 ~~(E)~~ W (W)
Location as "NE/CNW/SW" or footage from lines C. W/2 NW NW
Lease Owner Petroleum, Inc.
Lease Name Noah "D". Well No. 1
Office Address Route 2, Great Bend, Kansas
Character of Well (completed as Oil, Gas or Dry Hole) Oil
Date well completed July 11 1955
Application for plugging filed March 3 1959
Application for plugging approved March 6 1959
Plugging commenced March 12 1959
Plugging completed March 17 1959
Reason for abandonment of well or producing formation Depletion of producible zones
If a producing well is abandoned, date of last production March 8 1959
Was permission obtained from the Conservation Division or its agents before plugging was commenced? Yes

Name of Conservation Agent who supervised plugging of this well A. D. Fabricus
Producing formation Kansas City Depth to top 3534 Bottom 3762 Total Depth of Well 3938 Feet
Show depth and thickness of all water, oil and gas formations.

OIL, GAS OR WATER RECORDS

CASING RECORD

FORMATION	CONTENT	FROM	TO	SIZE	PUT IN	PULLED OUT
				8 5/8"	218'	none
				5 1/2"	3935'	2633'
Kansas City	Little oil and water	3576'	3580'			

Describe in detail the manner in which the well was plugged, indicating where the mud fluid was placed and the method or methods used in introducing it into the hole. If cement or other plugs were used, state the character of same and depth placed, from _____ feet to _____ feet for each plug set.

(Plugged back to 3610')

Filled hole with crushed rock from 3610' to 3570'. Placed 4 sacks cement on top of rock. Mudded up to 215' and made solid rock bridge. Placed 25 sacks cement on top of rock bridge and mudded up to 40'. Made solid rock bridge and filled hole to base of well cellar with cement.

RECEIVED
STATE CORPORATION COMMISSION

MAR 27 1959

CONSERVATION DIVISION
KANSAS

03-27-1959


(If additional description is necessary, use BACK of this sheet)
Name of Plugging Contractor Morgan Well Plugging Service
Address 102 West 18th Street, Hutchinson, Kansas

STATE OF Kansas, COUNTY OF Barton, ss.
Don Searle (employee of owner) or ~~OWNER OR OPERATOR~~ of the above-described well, being first duly sworn on oath, says: That I have knowledge of the facts, statements, and matters herein contained and the log of the above-described well as filed and that the same are true and correct. So help me God.

(Signature) Don Searle
Route 2, Great Bend, Kansas (Address)

SUBSCRIBED AND SWORN to before me this 24th day of March, 1959

Notary Public. *[Signature]*

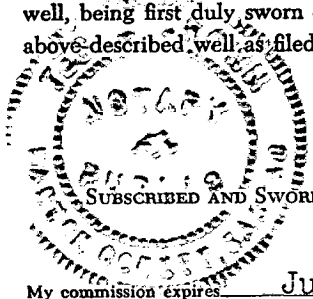

PLUGGING
FILE SEC. 35 T. 10 R. 22 W
BOOK PAGE 19 LINE 29

WELL LOG

15-065-00685-00-00

COMPANY Petroleum, Inc.

SEC. 35 T. 10S R. 22W

FARM NOAH 'D'

NO. 1

LOC. C W/2 NW NW


TOTAL DEPTH 3938'

COUNTY Graham

COMM. June 24, 1955

COMP. July 5, 1955

CONTRACTOR Garvey Drilling Company

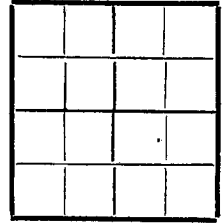

CASING 8-5/8" @ 216' w/150 sax
5-1/2" @ 3935' w/100 sax

ELEVATION 2271' RB

PRODUCTION Arbuckle

FIGURES INDICATE BOTTOM OF FORMATIONS

700	Sand & Shale
810	Shale & Shells
1764	Sand & Shale
1813	Anhydrite
2165	Shale & Shells
3470	Lime & Shale
3766	Lime
3860	Lime & Shale
3885	Lime & Chert
3938	Lime & Shale

Tops

Topeka:	3282 (-1011)
Heebner:	3493 (-1222)
Lansing:	3532 (-1261)
Conglomerate:	3907 (-1636)
Re-Worked Arbuckle:	3913 (-1642)
Arbuckle:	3920 (-1649)

R.T.D. 3938'

RECEIVED
STATE CORPORATION COMMISSION

MAR 27 1959

CONSERVATION DIVISION
Wichita, Kansas

03-27-1959

PLUGGING

FILE SEC. 35 T. 10 R. 22W
BOOK PAGE 19 LINE 29

State of KANSAS

County of SEDGWICK

SS:

I, Karl E. Becker


of

Petroleum, Inc.

upon oath state that the above and foregoing is a true and correct copy of the log of the NOAH 'D' #1 well

Subscribed and sworn to before me this 13th day of July 19 55

My Commission Expires: 8-11-58

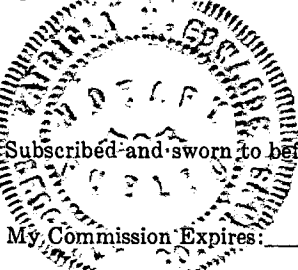

Karl E. Becker

Patricia M. Edwards

PATRICIA M. EDWARDS, Notary Public, State of Kansas
My Commission Expires August 11, 1958