

CARD MUST BE TYPED

State of Kansas
NOTICE OF INTENTION TO DRILL

CARD MUST BE SIGNED

(see rules on reverse side)

Starting Date: November 21, 1984
month day year

API Number 15- 065-22, 111-00-00

OPERATOR: License # 5544
Name Thomason Oil Company
Address P.O. Box 875
City/State/Zip Hays, KS 67601
Contact Person Earl L. Thomason
Phone (913) 625-9045

SE SW NW
(location) Sec 36 Twp 10 S, Rge 24 East West

2970
4290 Ft North from Southeast Corner of Section
Ft West from Southeast Corner of Section
(Note: Locate well on Section Plat on reverse side)

CONTRACTOR: License # 5128 Rig tag #36
Name Jay-Lan Corporation
City/State Hays, KS 67601

Nearest lease or unit boundary line 330 feet.
County Graham
Lease Name Ruder Well# 1

Well Drilled For: Well Class: Type Equipment:
 Oil Swd Infield Mud Rotary
 Gas Inj Pool Ext. Air Rotary
 OWWO Expl Wildcat Cable

Domestic well within 330 feet: yes no
Municipal well within one mile: yes no

If OWWO: old well info as follows:

Operator
Well Name
Comp Date Old Total Depth
Projected Total Depth 3950 feet
Projected Formation at TD Base K/C
Expected Producing Formations L/KC

Depth to Bottom of fresh water
Lowest usable water formation Dakota
Depth to Bottom of usable water 1100 feet
Surface pipe by Alternate: 1 2
Surface pipe to be set 250' feet
Conductor pipe if any required N/A feet
Ground surface elevation N/A feet MSL
This Authorization Expires 5-8-85
Approved By 11-8-84 PC

I certify that we will comply with K.S.A. 55-101, et seq., plus eventually plugging hole to K.C.C. specifications.


Date 11-7-84 Signature of Operator or Agent

Earl L. Thomason Title Owner

MHC/KOHE 11/8/84

Must be filed with the K.C.C. five (5) days prior to commencing well
This card void if drilling not started within six (6) months of date received by K.C.C.

A Regular Section of Land
1 Mile = 5,280 Ft.

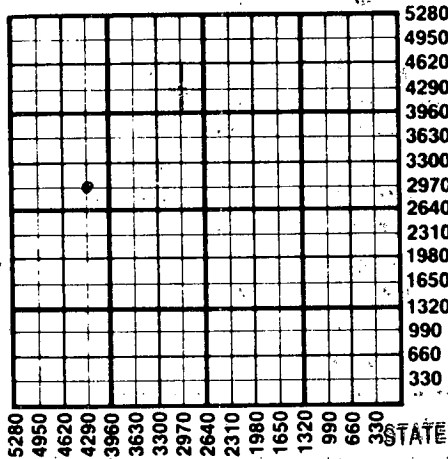

Important procedures to follow :

1. Notify District office before setting surface casing.
2. Set surface casing by circulating cement to the top.
3. File completion forms ACO-1 with K.C.C. within 90 days of well completion, following instructions on ACO-1, side 1, and including copies of wireline logs.
4. Notify District office 48 hours prior to old well workover or re-entry.
5. Prior to plugging, prepare a plugging plan, then obtain agreement from the appropriate district office for an approved plugging plan.
6. Submit plugging report (CP-4) to K.C.C. after plugging is completed.
7. Obtain an approved injection docket number before disposing of salt water.
8. Notify K.C.C. within 10 days when injection commences or terminates.
9. If an alternate 2 completion, cement in the production pipe from below any usable water to surface within 120 days of spud date.

RECEIVED

STATE CORPORATION COMMISSION

11-08-84
NOV 08 1984

CONSERVATION DIVISION
Wichita, Kansas

State Corporation Commission of Kansas
Conservation Division
200 Colorado Derby Building
Wichita, Kansas 67202
(316) 263-3238