

15-065-20484-00-00

STATE OF KANSAS  
STATE CORPORATION COMMISSION

Form CP-4

Give All Information Completely  
Make Required Affidavit  
Mail or Deliver Report to:  
Conservation Division  
State Corporation Commission  
212 No. Market  
Wichita, Kansas 67202

WELL PLUGGING RECORD

Graham County, Sec. 12 Twp. 10 Rge. 25 (E) W (W)

Location as "NE/CNW/SW" or footage from lines SW SW SW

Lease Owner Don E. Pratt Oil Operations

Lease Name F. Richmeier Well No. 1

Office Address Drawer 370, Hays, Kansas 67601

Character of Well (completed as Oil, Gas or Dry Hole) Dry Hole

Date well completed August 9 16 19 71

Application for plugging filed August 9 16 19 71

Application for plugging approved August 9 16 19 71


Plugging commenced August 9 16 19 71

Plugging completed August 9 16 19 71

Reason for abandonment of well or producing formation Dry Hole

If a producing well is abandoned, date of last production \_\_\_\_\_ 19 \_\_\_\_\_

Was permission obtained from the Conservation Division or its agents before plugging was commenced? Yes

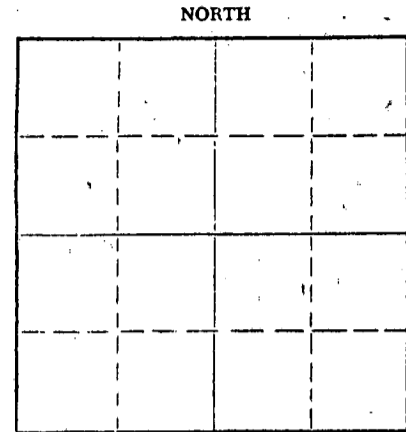

Locate well correctly on above Section Plat

Name of Conservation Agent who supervised plugging of this well Bill Nichols, Morland, Kansas

Producing formation \_\_\_\_\_ Depth to top \_\_\_\_\_ Bottom \_\_\_\_\_ Total Depth of Well 4,050 Feet

Show depth and thickness of all water, oil and gas formations.

OIL, GAS OR WATER RECORDS

CASING RECORD

FORMATION	CONTENT	FROM	TO	SIZE	PUT IN	PULLED OUT
Surface Pipe				8 5/8"	155'	

Describe in detail the manner in which the well was plugged, indicating where the mud fluid was placed and the method or methods used in introducing it into the hole. If cement or other plugs were used, state the character of same and depth placed, from \_\_\_\_\_ feet to \_\_\_\_\_ feet for each plug set.

- 1st plug set at 1,200' with 100 sacks cement
- 2nd plug set at 185' with 25 sacks cement
- 3rd plug set at 40' with 10 sacks cement

RECEIVED  
STATE CORPORATION COMMISSION  
SEP 20 1971  
CONSERVATION DIVISION  
Wichita, Kansas


(If additional description is necessary, use BACK of this sheet)  
Name of Plugging Contractor Dreiling Oil, Inc.  
Address R R #2, Victoria, Kansas 67671

STATE OF Kansas, COUNTY OF Ellis, ss.

\_\_\_\_\_, (employee of owner) or (owner or operator) of the above-described well, being first duly sworn on oath, says: That I have knowledge of the facts, statements, and matters herein contained and the log of the above-described well as filed and that the same are true and correct. So help me God.

(Signature) Leo F. Dreiling  
LEO F. DREILING, RR#2, VICTORIA, KANSAS 67671  
(Address)

SUBSCRIBED AND SWORN TO before me this 18th day of September, 19 71

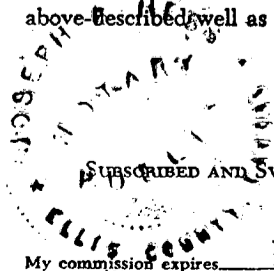

Joseph A. Hess  
JOSEPH A. HESS - NOTARY PUBLIC Notary Public.

# DREILING OIL, INC.

Victoria, Kansas 67671

15-065-20484-00-00

## WELL LOG

Company	Don E. Pratt Oil Operations	Sec. 12	Twp. 10	Rng. 25
	Drawer 370, Hays, Kansas 67601			
Farm	F. Richmeier No. 1	Location	SW SW SW	
Total Depth	4,050'	County	Graham	
Comm.	9-9-71	Comp.	9-16-71	Elevation: 2484' K. B.
Contractor	Dreiling Oil, Inc.			2481' D. F.
				2479' G. R.

Casing Record  
155' - 8 5/8"

Cement Record  
130 Sacks Cement

Production:

Figures Indicate Bottom of Formations

0'	60'	Top Soil
60'	75'	Sand & Gravel
75'	155'	Blue Shale
155'	710'	Shale
710'	1630'	Shale with Sand Streaks
1630'	1876'	Shale & Sand
1876'	2103'	Red Bed Shale
2103'	2145'	Anhydrite
2145'	2176'	Shale & Lime
2176'	2630'	Shale & Lime
2630'	2741'	Shale
2741'	2891'	Shale & Lime
2891'	3157'	Lime, Shale
3157'	3515'	Shale & Lime
3515'	3681'	Lime & Shale
3681'	3790'	Lime & Shale
3790'	3839'	Lime
3839'	4050'	Lime

STATE OF KANSAS)  
  )ss  
COUNTY OF ELLIS)

RECEIVED  
STATE CONSERVATION COMMISSION  
SEP 20 1971  
CONSERVATION DIVISION  
Wichita, Kansas

I, Leo F. Dreiling, of the Dreiling Oil, Inc., upon oath states that the above and foregoing is true and correct copy from the Daily Drilling Report from your F. Richmeier #1.

*Leo F. Dreiling*  
\_\_\_\_\_  
LEO F. DREILING

Subscribed and sworn to before me this 18th day of September, 1971.

*Joseph A. Hess*  
\_\_\_\_\_  
JOSEPH A. HESS - NOTARY PUBLIC

My commission expires: September 19, 1974

