


WELL PLUGGING RECORD

Give All Information Completely  
Make Required Affidavit  
Mail or Deliver Report to:  
Conservation Division  
State Corporation Commission  
211 No. Broadway  
Wichita, Kansas

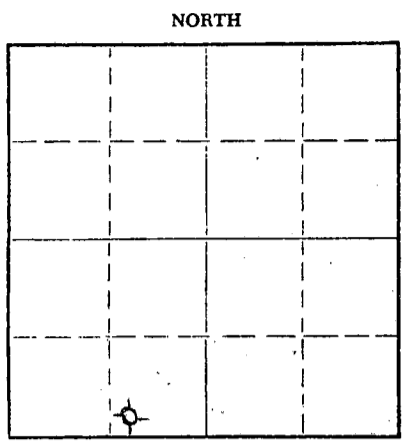

NORTH

Locate well correctly on above  
Section Plat

Graham County, Sec. 13 Twp. 10 Rge. 25 (E) (W)

Location as "NE/CNW&SW&W" or footage from lines SW SE SW

Lease Owner D. G. Hansen

Lease Name Knoll Well No. #1

Office Address Logan, Kansas

Character of Well (completed as Oil, Gas or Dry Hole) Dry Hole

Date well completed March 26 19 63

Application for plugging filed March 26 19 63

Application for plugging approved March 26 19 63

Plugging commenced March 26 19 63

Plugging completed March 26 19 63

Reason for abandonment of well or producing formation Too low structurally

If a producing well is abandoned, date of last production \_\_\_\_\_ 19 \_\_\_\_\_

Was permission obtained from the Conservation Division or its agents before plugging was commenced? YES

Name of Conservation Agent who supervised plugging of this well Eldon Petty, Hays, Kansas

Producing formation \_\_\_\_\_ Depth to top \_\_\_\_\_ Bottom \_\_\_\_\_ Total Depth of Well 4010 Feet

Show depth and thickness of all water, oil and gas formations.

OIL, GAS OR WATER RECORDS

CASING RECORD

FORMATION	CONTENT	FROM	TO	SIZE	PUT IN	PULLED OUT
				8-5/8"	208.61'	NONE

Describe in detail the manner in which the well was plugged, indicating where the mud fluid was placed and the method or methods used in introducing it into the hole. If cement or other plugs were used, state the character of same and depth placed, from \_\_\_\_\_ feet to \_\_\_\_\_ feet for each plug set.

Filled hole with heavy mud to 550'.  
Set plug. Put in 1/2 sk. hulls and  
20 sacks cement. Filled to 190'.  
Set plug. Put in 1/2 sack hulls and  
20 sacks cement. Filled with heavy mud  
up to 40'. Set plug. Filled to  
top with 1/2 sack hulls and 10 sacks  
cement.

RECEIVED  
STATE CORPORATION COMMISSION

APR 5 1963

CONSERVATION DIVISION  
Wichita, Kansas

Name of Plugging Contractor C-G Drilling Co.  
Address 107 Rule Building, Wichita 2, Kansas

STATE OF KANSAS COUNTY OF Sedgwick, ss.  
Jay H. Galloway (employee of owner) or (owner or operator) of the above-described

well, being first duly sworn on oath, says: That I have knowledge of the facts, statements, and matters herein contained and the log of the above-described well as filed and that the same are true and correct. So help me God.

(Signature) Jay H. Galloway  
Jay H. Galloway 107 Rule Bldg.  
(Address)

SUBSCRIBED AND SWORN to before me this 29 day of March, 19 63

My commission expires May 20, 1963  
Vicky Jacobs Notary Public.



