


15-065-20355-00-00

STATE OF KANSAS  
STATE CORPORATION COMMISSION

Form CP-4

Give All Information Completely  
Make Required Affidavit  
Mail or Deliver Report to:  
Conservation Division  
State Corporation Commission  
212 No. Market  
Wichita, Kansas 67202

WELL PLUGGING RECORD

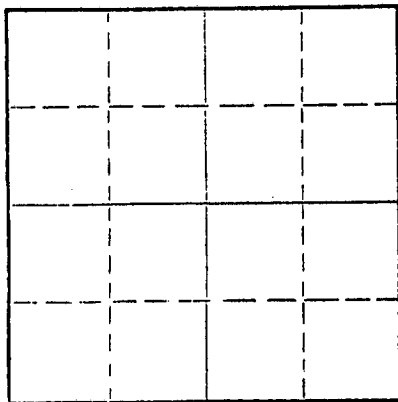

Locate well correctly on above  
Section Plat

Graham County. Sec. 13 Twp. 10 Rge. 25 (E) W (W)  
Location as "NE/CNW%SW%" or footage from lines SW SE NE  
Lease Owner Don E. Pratt Oil Operations  
Lease Name Knoll Well No. 1  
Office Address P. O. Drawer 370, Hays, Kansas 67601  
Character of Well (completed as Oil, Gas or Dry Hole) Dry Hole  
Date well completed 8-5 1970  
Application for plugging filed 8-5 1970  
Application for plugging approved 8-5 1970  
Plugging commenced 8-5 1970  
Plugging completed 8-5 1970  
Reason for abandonment of well or producing formation Dry Hole

If a producing well is abandoned, date of last production 19  
Was permission obtained from the Conservation Division or its agents before plugging was commenced? Yes

Name of Conservation Agent who supervised plugging of this well Bill Nichols  
Producing formation \_\_\_\_\_ Depth to top \_\_\_\_\_ Bottom \_\_\_\_\_ Total Depth of Well \_\_\_\_\_ Feet  
Show depth and thickness of all water, oil and gas formations.

OIL, GAS OR WATER RECORDS

CASING RECORD

FORMATION	CONTENT	FROM	TO	SIZE	PUT IN	PULLED OUT
Surface Pipe				8 5/8"	154'	

Describe in detail the manner in which the well was plugged, indicating where the mud fluid was placed and the method or methods used in introducing it into the hole. If cement or other plugs were used, state the character of same and depth placed, from \_\_\_\_\_ feet to \_\_\_\_\_ feet for each plug set.

1st plug was set at 1190' with 100 sacks cement  
2nd plug was set at 185' with 25 sacks cement  
3rd plug was set at 40' with 10 sacks cement

RECEIVED  
STATE CORPORATION COMMISSION  
AUG 12 1970  
CONSERVATION DIVISION  
Wichita, Kansas

(If additional description is necessary, use BACK of this sheet)

Name of Plugging Contractor L. J. Dreiling & Sons, Inc.  
Address Victoria, Kansas 67671

STATE OF KANSAS, COUNTY OF ELLIS, ss.  
I, Leo F. Dreiling (employee of owner) or (owner or operator) of the above-described well, being first duly sworn on oath, says: That I have knowledge of the facts, statements, and matters herein contained and the log of the above-described well as filed and that the same are true and correct. So help me God.

(Signature) Leo F. Dreiling  
LEO F. DREILING, ROUTE 2, VICTORIA, KANSAS 67671  
(Address)

SUBSCRIBED AND SWORN to before me this 10th day of August, 19 70



Joseph A. Hess  
JOSEPH A. HESS  
Notary Public.

My commission expires September 19, 1970

# L. J. DREILING AND SONS, INC.

Victoria, Kansas 67671

## WELL LOG

Company Don E. Pratt Oil Operations  
P. O. Drawer 370  
Hays, Kansas 67601

Sec. 13 Twp. 10 Rng. 25

Farm Knoll No. 1

Location SW SE NE

Total Depth 3744'

County Graham

Comm. 8-1-70 Comp. 8-5-70

Elevation: 2458' K. B.

Contractor L. J. Dreiling & Sons, Inc.  
Victoria, Kansas 67671

2455' D. F.

2453' G. R.

Casing Record

Cement Record

Production:

154' - 8 5/8"

135 sacks cement

D & A

### Figures Indicate Bottom of Formations

0'	65'	Top Soil, Yellow Gravel & Shale
65'	105'	Blue Shale
105'	154'	Blue Shale
154'	1250'	Shale & Sand
1250'	1650'	Shale
1650'	1880'	Sand
1880'	1950'	Red Bed & Shale
1950'	2118'	Shale
2118'	2159'	Anhydrite
2159'	2593'	Shale
2593'	2875'	Shale
2875'	3040'	Shale & Lime
3040'	3280'	Shale & Lime
3280'	3455'	Shale & Lime
3455'	3615'	Shale & Lime
3615'	3744'	Lime
3744'	T.D.	

RECEIVED  
STATE CORPORATION COMMISSION  
AUG 12 1970  
CONSERVATION DIVISION  
Wichita, Kansas


STATE OF KANSAS)  
)ss  
COUNTY OF ELLIS)

I, Leo F. Dreiling, of the L. J. Dreiling & Sons, Inc., upon oath states that the above and foregoing is a true and correct copy from the Daily Drilling Report from your Knoll #1.

*Leo F. Dreiling*  
\_\_\_\_\_  
LEO F. DREILING

Subscribed and sworn to before me this 10th day of August, 1970.

*Joseph A. Hess*  
\_\_\_\_\_  
JOSEPH A. HESS NOTARY PUBLIC

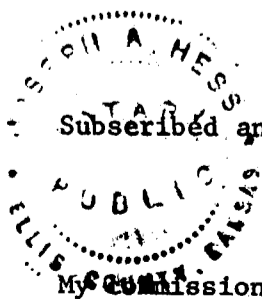

My Commission expires: September 19, 1970