


STATE OF KANSAS
STATE CORPORATION COMMISSION

WELL PLUGGING RECORD

Give All Information Completely
Make Required Affidavit
Mail or Deliver Report to:
Conservation Division
State Corporation Commission
211 No. Broadway
Wichita, Kansas

Graham County. Sec. 26 Twp. 10S Rge. (E) 25 (W)
Location as "NE/CNW&SW¼" or footage from lines C SW SW
Lease Owner Chief Drilling Co., Inc.
Lease Name KNOLL Well No. 1
Office Address Box 797 - Great Bend, Kansas 67530
Character of Well (completed as Oil, Gas or Dry Hole) _____
Date well completed 3/12 1968
Application for plugging filed 3/12 1968
Application for plugging approved 3/12 1968
Plugging commenced 3/12 1968
Plugging completed 3/12 1968
Reason for abandonment of well or producing formation Dry Hole

NORTH

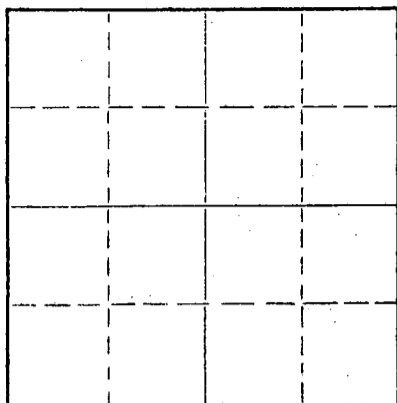

Locate well correctly on above
Section Plat

If a producing well is abandoned, date of last production _____ 19____
Was permission obtained from the Conservation Division or its agents before plugging was commenced? Yes

Name of Conservation Agent who supervised plugging of this well W.L. Nichols - Morland, Kansas
Producing formation _____ Depth to top _____ Bottom _____ Total Depth of Well 3527 Feet
Show depth and thickness of all water, oil and gas formations.

OIL, GAS OR WATER RECORDS

CASING RECORD

FORMATION	CONTENT	FROM	TO	SIZE	PUT IN	PULLED OUT
		0	205	8-5/8"	205	None

Describe in detail the manner in which the well was plugged, indicating where the mud fluid was placed and the method or methods used in introducing it into the hole. If cement or other plugs were used, state the character of same and depth placed, from _____ feet to _____ feet for each plug set.

Wooden plug set @ 1225'
Mixed 100 sacks cement through drill pipe
Wooden plug set @ 210'
Mixed 20 sacks cement through drill pipe
Wooden plug set @ 40'
Mixed 10 sacks cement through drill pipe


RECEIVED
STATE CORPORATION COMMISSION
MAR 19 1968
CONSERVATION DIVISION
Wichita, Kansas

(If additional description is necessary, use BACK of this sheet)
Name of Plugging Contractor Chief Drilling Co., Inc.
Address Box 797 - Gt. Bend, Kansas 67530

STATE OF KANSAS, COUNTY OF BARTON, ss.
Jim Robinson (employee of owner) or (owner or operator) of the above-described well, being first duly sworn on oath, says: That I have knowledge of the facts, statements, and matters herein contained and the log of the above-described well as filed and that the same are true and correct. So help me God.

(Signature) Jim Robinson
Box 797 - Gt. Bend, Kansas 67530
(Address)

SUBSCRIBED AND SWORN TO before me this 13th day of March, 1968

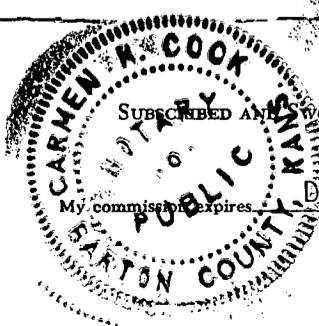

Carmen R. Cook
Carmen R. Cook, Notary Public.

WELL LOG

Chief Drilling Co., Inc.
 Box 797
 Great Bend, Kansas 67530

KNOLL #1
 C SW SW Section 26-10S-25W
 Graham County, Kansas

Contractor: Chief Drilling Co., Inc.

Commenced: 3-8-68
 Completed: 3-12-68

Casing Record: 8-5/8" @ 205' w/165 sacks 60/40 Pozmix, 2% Gel.

DRY & ABANDONED

<u>FORMATION</u>	<u>FROM</u>	<u>TO</u>	<u>ELEVATION</u>
			2481 Gr.
Surface Sand & Clay	0	40	2483 D.F.
Shale & Sand Streaks	40	205	2486 K.B.
Shale	205	960	
Shale & Sand Streaks	960	1190	
Shale & Sand	1190	1730	
Sand	1730	1920	
Shale (Red Bed) (Sand Streaks)	1920	1930	
Shale	1930	2149	
Anhydrite	2149	2185	
Shale	2185	2370	
Shale, Shells & Red Bed	2370	2785	
Shale & Shells	2785	2905	
Shale & Lime	2905	3527	
Total Depth	3527		

FORMATION TOPS
 Anhydrite 2149 + 337
 Upper Penn Marker 3450 - 964
 Total Depth 3527 -1041

RECEIVED
 STATE CORPORATION COMMISSION
 MAR 19 1968
 CONSERVATION DIVISION
 Wichita, Kansas

STATE OF KANSAS, COUNTY OF BARTON) SS

I hereby certify that the above is a true and correct copy of the Driller's Log of the well drilled in the C SW SW Section 26-10S-25W, Graham County, Kansas, to the best of my knowledge and belief.

CHIEF DRILLING CO., INC.

Thomas G. Wesselowski

Thomas G. Wesselowski, Geologist

Subscribed and sworn to before me this 15th day of March, 1968.

Carmen R. Cook

Carmen R. Cook, Notary Public

My commission expires: Dec. 12, 1970.

