


STATE OF KANSAS
STATE CORPORATION COMMISSION

Form CP-4

Give All Information Completely
Make Required Affidavit
Mail or Deliver Report to:
Conservation Division
State Corporation Commission
211 No. Broadway
Wichita, Kansas

WELL PLUGGING RECORD

NORTH

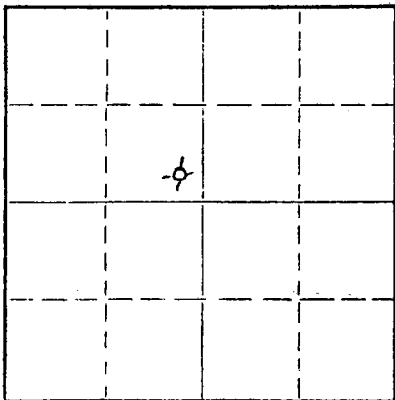

Locate well correctly on above
Section Plat

Graham County, Sec. 26 Twp. 10S Rge. (E) 25W(W)
Location as "NE/CNW&SW&" or footage from lines SE $\frac{1}{4}$ SE $\frac{1}{4}$ NW $\frac{1}{4}$
Lease Owner Birmingham-Bartlett Drilling Co.
Lease Name Knoll "C" Well No. 1
Office Address 300 Kaufman Building, Wichita, Kansas, 67202
Character of Well (completed as Oil, Gas or Dry Hole) Dry Hole
Date well completed November 22, 1965
Application for plugging filed (verbally approved) December 1, 1965
Application for plugging approved (" ") 19
Plugging commenced November 22, 1965
Plugging completed November 22, 1965
Reason for abandonment of well or producing formation

If a producing well is abandoned, date of last production 19
Was permission obtained from the Conservation Division or its agents before plugging was commenced? Yes

Name of Conservation Agent who supervised plugging of this well W. L. Nichols
Producing formation Depth to top Bottom Total Depth of Well 3852 Feet
Show depth and thickness of all water, oil and gas formations.

OIL, GAS OR WATER RECORDS

CASING RECORD

FORMATION	CONTENT	FROM	TO	SIZE	PUT IN	PULLED OUT
		0	208'	8-5/8"	208'	None

Describe in detail the manner in which the well was plugged, indicating where the mud fluid was placed and the method or methods used in introducing it into the hole. If cement or other plugs were used, state the character of same and depth placed, from feet to feet for each plug set.

Plugged hole:

20-sacks cement mixed and poured through drill pipe on bottom plug at 540',
20 sacks mixed & poured on middle plug set at 200'
10 sakks on top plug set at 40'.

RECEIVED
STATE CORPORATION COMMISSION

DEC - 2 1965

12-02-65

CONSERVATION DIVISION
Wichita, Kansas

(If additional description is necessary, use BACK of this sheet)
Name of Plugging Contractor Birmingham-Bartlett Drilling Co.
Address (given above)

STATE OF KANSAS, COUNTY OF SEDGWICK, ss.
Richard Hindery, partner of Birmingham-Bartlett Drilling Co., owner & operator
well, being first duly sworn on oath, says: That I have knowledge of the facts, statements, and matters herein contained and the log of the above-described well as filed and that the same are true and correct. So help me God. BIRMINGHAM-BARTLETT DRILLING CO.

(Signature) By Richard Hindery
300 Kaufman Bldg., Wichita, Kansas, 67202
(Address)

SUBSCRIBED AND SWORN to before me this 1st day of December, 1965.

My commission expires November 29, 1966.

Vivian F. Yinger
Notary Public.

KNOLL 'C' #1 WELL

LOCATION: SE $\frac{1}{4}$ SE $\frac{1}{4}$ NW $\frac{1}{4}$ Sec. 26-10S-25W
Graham County, Kansas

OWNER, OPERATOR
and CONTRACTOR Birmingham-Bartlett Drilling Co.
300 Kaufman Building
Wichita, Kansas, 67202

SURFACE CASING: 8-5/8" cemented at 208'
with 175 sacks cement

OIL STRING: None set. Plugged 11-22-65
O & A.

SPUDDED: 11-16-65

DRILLING COMPLETED: 11-22-65

KB: 2512'

L O G

(Figures indicate bottom of formation)

0 -	50	Shale
	70	Sand
	150	Shale and clay
	490	Shale
	600	Sand
	1700	Shale and shells
	1930	Sand
	1970	Shale and red bed
	2172	Red bed
	2214	Anhydrite
	2550	Shale and shells
	2825	Shale
	3847	Lime and shale
	3852	Lime
	3852	Rotary Total Depth Dry and Abandoned

The undersigned, Richard Hindery, one of the partners of Birmingham-Bartlett Drilling Co., hereby certifies that the above is a true and correct log of the KNOLL 'C' #1 WELL, as shown in the daily drilling reports.

BIRMINGHAM-BARTLETT DRILLING CO.

By Richard Hindery
Richard Hindery, Partner

Subscribed and sworn to before me
this 1st day of December, 1965.

Vivian F. Yinger
Vivian F. Yinger, Notary Public

My commission expires November 29, 1966.

DEC 1 1965