

15-065-30048-00-00

STATE OF KANSAS  
STATE CORPORATION COMMISSION

Form CP-4

Give All Information Completely  
Make Required Affidavit  
Mail or Deliver Report to:  
Conservation Division  
State Corporation Commission  
211 No. Broadway  
Wichita, Kansas

WELL PLUGGING RECORD

Graham County, Sec. 28 Twp. 10S Rge. (E) 24 (W)

Location as "NE/CNWxSWx" or footage from lines C SW NE

Lease Owner Chief Drilling Co., Inc.

Lease Name McCall Well No. 1

Office Address Box 797 - Great Bend, Kansas

Character of Well (completed as Oil, Gas or Dry Hole) Dry Hole/ Core

Date well completed 5/25 1965

Application for plugging filed 5/25 1965

Application for plugging approved 5/25 1965


Plugging commenced 5/25 1965

Plugging completed 5/25 1965

Reason for abandonment of well or producing formation Dry Hole / Core hole test

If a producing well is abandoned, date of last production 19

Was permission obtained from the Conservation Division or its agents before plugging was commenced? Yes

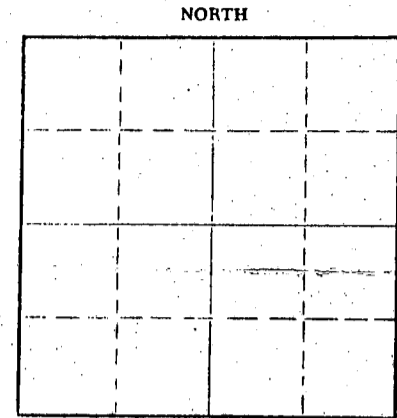

Locate well correctly on above Section Plat

Name of Conservation Agent who supervised plugging of this well W.L. Nichols - Moreland, Kansas

Producing formation Depth to top Bottom Total Depth of Well 2850 Feet

Show depth and thickness of all water, oil and gas formations.

OIL, GAS OR WATER RECORDS

CASING RECORD

FORMATION	CONTENT	FROM	TO	SIZE	PUT IN	PULLED OUT
No surface pipe set because of stratigraphic core hole test						

Describe in detail the manner in which the well was plugged, indicating where the mud fluid was placed and the method or methods used in introducing it into the hole. If cement or other plugs were used, state the character of same and depth placed, from feet to feet for each plug set.

Wooden plug set @ 540'  
Mixed 20 sacks cement through drill pipe with pump truck  
Hulls and wooden plug set @ 180'  
Mixed 60 sacks cement through drill pipe with pump truck

RECEIVED  
STATE CORPORATION COMMISSION

MAY 28 1965

05-28-65

CONSERVATION DIVISION  
Wichita, Kansas


Name of Plugging Contractor Chief Drilling Co., Inc.  
Address Box 797 - Great Bend, Kansas

STATE OF KANSAS, COUNTY OF BARTON, ss.  
V. Richard Hoover, President (employee of owner) or (owner or operator) of the above-described

well, being first duly sworn on oath, says: That I have knowledge of the facts, statements, and matters herein contained and the log of the above-described well as filed and that the same are true and correct. So help me God. CHIEF DRILLING CO., INC.

(Signature) Richard Hoover  
Box 797 - Great Bend, Kansas (Address)

SUBSCRIBED AND SWORN to before me this 25th day of May, 1965

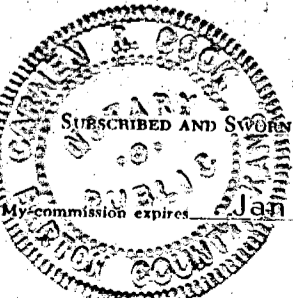

Carmen R. Cook, Notary Public.

15-065-30048-00-0

WELL LOG

Chief Drilling Co., Inc.  
Box 797  
Great Bend, Kansas

McCALL #1  
C SW NE Sec. 28-10S-24W  
Graham County, Kansas

Contractor: Chief Drilling Co., Inc.

Commenced: 5-19-65  
Completed: 5-25-65

Dry & Abandoned @ 2850'  
Stratigraphic Core Hole Test

<u>FORMATION</u>	<u>FROM</u>	<u>TO</u>	<u>ELEVATION</u>
Shale	0	400	2402 Gr.
Shale & Sand	400	1440	2404 D.F.
Shale	1440	2014	2407 K.B.
Anhydrite	2014	2058	
Shale & Shells	2058	2125	
Shale & Lime	2125	2568	
Lime	2568	2850	
Total Depth	2850		

<u>FORMATION TOPS</u>		<u>Log Tops</u>
Anhydrite	2014	+ 393
Ft. Riley	2610	- 203
2nd Ft. Filey Marker	2797	- 390
Total Depth	2850	- 443

STATE OF KANSAS, COUNTY OF BARTON) SS

I hereby certify that the above is a true and correct copy of the Driller's Log of the well drilled in the C SW NE Section 28-10S-24W, Graham County, Kansas, to the best of my knowledge and belief.

CHIEF DRILLING CO., INC.

V. Richard Hoover  
V. Richard Hoover, President

Subscribed and sworn to before me this 25th day of May, 1965.

Carmen R. Cook  
Carmen R. Cook, Notary Public

My commission expires: Jan. 26, 1967.



**RECEIVED**  
STATE CORPORATION COMMISSION

MAY 28 1965

CONSERVATION DIVISION  
Wichita, Kansas