


STATE OF KANSAS
STATE CORPORATION COMMISSION
200 Colorado Derby Bldg.
Wichita, Kansas 67202

WELL PLUGGING RECORD

Give All Information Completely
Make Required Affidavit

COUNTY Graham SEC. 34 TWP. 10S RGE. 24W E/W
Location as in quarters or footage from lines:
440' FEL & 440' FSL, SW/4

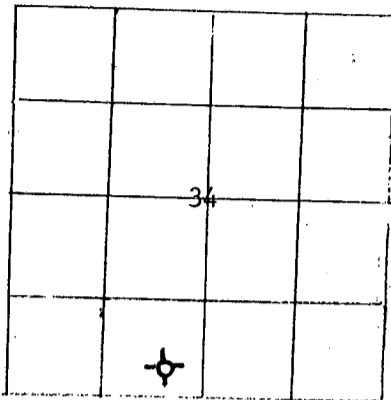

Lease Owner John O. Farmer, Inc.
Lease Name Brungardt Well No. #34-1
Office Address P.O. Box 352, Russell, KS 67665
Character of Well (Completed as Oil, Gas or Dry Hole): Dry Hole
Date Well Completed April 7, 1982
Application for plugging filed Yes
Plugging commenced _____
Plugging completed 1:00 P.M., 4-7-82
Reason for abandonment of well or producing formation _____

Locate Well
correctly on above
Section Platt.

Was permission obtained from the Conservation Division or it's
Agent's before plugging was commenced? Yes

Name of Conservation Agent who supervised plugging of this well Gilbert Balthazor

Producing formation _____ Depth to top _____ bottom _____ T.D. _____

Show depth and thickness of all water, oil and gas formations.

OIL, GAS OR WATER RECORDS

Casing Record

Formation	Content	From	To	Size	Put in	Pulled Out
				8-5/8"	221'	

Describe in detail the manner in which the well was plugged, indicating where the mud fluid was placed and the method or methods used in introducing it into the hold. If cement or other plugs were used, state the character of same and depth placed, from _____ feet to _____ feet for each plug set.

- Plug #1 @ 1000' w/70 sxs. cement
- Plug #2 @ 240' w/40 sxs. cement
- Plug #3 @ 40' w/10 sxs. cement
- 10 sxs. cement in rathole

(If additional description is necessary, use BACK of this sheet)

Name of Plugging Contractor John O. Farmer, Inc.
P.O. Box 352, Russell, KS 67665

STATE OF Kansas COUNTY OF Russell, ss.

John O. Farmer III (~~employee of owner~~) or (owner or operator) of the above-described well, being first duly sworn on oath, says: That I have knowledge of the facts, statements, and matters herein contained and the log of the above-described well as filed and that the same are true and correct. So help me God.

(Signature) John O. Farmer III
P.O. Box 352, Russell, KS 67665
(Address)

RECEIVED
APR 15 1982
STATE CORPORATION COMMISSION
CONSERVATION DIVISION
Wichita Kansas

SUBSCRIBED AND SWORN TO before me this 13th day of April, 19 82

Margaret A. Schulte
Margaret A. Schulte Notary Public.

My Commission expires: January 27, 1985

