

15-065-21449-00-00

STATE OF KANSAS  
STATE CORPORATION COMMISSION


Give All Information Completely  
Make Required Affidavit  
Mail or Deliver Report to:  
Conservation Division  
State Corporation Commission  
212 North Market, Insurance Bldg.  
Wichita, Kansas

WELL PLUGGING RECORD

Graham County, Sec. 33 Twp. 10S Rge. 24W (W) (W)

Location as "NE/CNW/SW" or footage from lines NE SE SE  
Lease Owner John O. Farmer, Inc.  
Lease Name Tidball Well No. #1-33  
Office Address P.O. Box 352, Russell, KS 67665  
Character of Well (completed as Oil, Gas or Dry Hole) Dry Hole  
Date well completed July 24, 19 81  
Application for plugging filed Yes 19  
Application for plugging approved 19  
Plugging commenced 19  
Plugging completed 5:30 P.M., July 24, 19 81  
Reason for abandonment of well or producing formation \_\_\_\_\_

NORTH

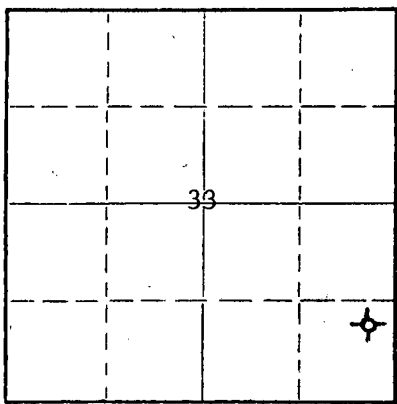

Locate well correctly on above  
Section Plat

If a producing well is abandoned, date of last production \_\_\_\_\_ 19  
Was permission obtained from the Conservation Division or its agents before plugging was commenced? Yes

Name of Conservation Agent who supervised plugging of this well Gilbert Balthazor  
Producing formation \_\_\_\_\_ Depth to top \_\_\_\_\_ Bottom \_\_\_\_\_ Total Depth of Well \_\_\_\_\_ Feet  
Show depth and thickness of all water, oil and gas formations.

OIL, GAS OR WATER RECORDS

CASING RECORD

FORMATION	CONTENT	FROM	TO	SIZE	PUT IN	PULLED OUT

Describe in detail the manner in which the well was plugged, indicating where the mud fluid was placed and the method or methods used in introducing it into the hole. If cement or other plugs were used, state the character of same and depth placed, from \_\_\_\_\_ feet to \_\_\_\_\_ feet for each plug set.

Plug #1 @ 1000' w/60 sxs. cement, circulated mud 10 min.  
Plug #2 @ 220' w/30 sxs. cement  
Plug #3 @ 40' w/10 sxs. cement

(If additional description is necessary, use BACK of this sheet)

Name of Plugging Contractor John O. Farmer, Inc.  
Address P.O. Box 352, Russell, KS 67665

STATE OF Kansas COUNTY OF Russell, ss.  
John O. Farmer III (owner or operator) of the above-described

well, being first duly sworn on oath, says: That I have knowledge of the facts, statements, and matters herein contained and the log of the above-described well as filed and that the same are true and correct. So help me God.

(Signature) John O. Farmer III  
P.O. Box 352, Russell, KS 67665  
(Address)

SUBSCRIBED AND SWORN to before me this 3rd day of August, 19 81

January 27, 1985

Margaret A. Schulte  
Margaret A. Schulte, Notary Public.  
STATE CORPORATION COMMISSION

ROBERTS-HUTCHINSON, KS.

AUG 4 1981

CONSERVATION DIVISION  
Wichita, Kansas




**KANSAS DRILLERS LOG**

S. 33 T. 10S R. 24W<sup>XX</sup>  
W

Loc. NE SE SE

County Graham

640 Acres  
N

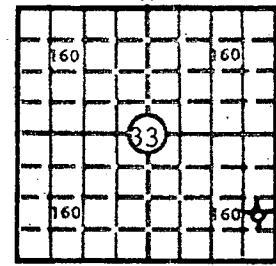

Locate well correctly  
Elev.: Gr. 2359'

DF 2362' KB 2364'

API No. 15 065 21,449  
County Number

Operator John O. Farmer, Inc.

Address P.O. Box 352, Russell, KS 67665

Well No. #1 Lease Name Tidball

Footage Location 990 feet from XX (S) line 330 feet from (E) XX line

Principal Contractor John O. Farmer, Inc. Geologist Sam L. Farmer

Spud Date 7-16-81 Total Depth 3955' P.B.T.D.

Date Completed 7-24-81 Oil Purchaser

**CASING RECORD**

Report of all strings set — surface, intermediate, production, etc.

Purpose of string	Size hole drilled	Size casing set (in O.D.)	Weight lbs/ft.	Setting depth	Type cement	Socks	Type and percent additives
Surface	12-1/4"	8-5/8"	24	214'	Common	175	

**LINER RECORD**

**PERFORATION RECORD**

Top, ft.	Bottom, ft.	Sacks cement	Shots per ft.	Size & type	Depth interval

**TUBING RECORD**

Size	Setting depth	Packer set at

**ACID, FRACTURE, SHOT, CEMENT SQUEEZE RECORD**

Amount and kind of material used	Depth interval treated

RECEIVED  
STATE CORPORATION COMMISSION  
AUG 4 1981  
CONSERVATION DIVISION  
Wichita, Kansas

**INITIAL PRODUCTION**

Date of first production                      Producing method (flowing, pumping, gas lift, etc.)                     

RATE OF PRODUCTION PER 24 HOURS	Oil	Gas	Water	Gas-oil ratio
	bbis.	bbis.	MCF	bbis.

Disposition of gas (vented, used on lease or sold)                      Producing interval(s)                      CFPB

INSTRUCTIONS: As provided in KCC Rule 82-2-125, within 90 days after completion of a well, one completed copy of this Drillers Log shall be transmitted to the State Geological Survey of Kansas, 4150 Monroe Street, Wichita, Kansas 67209. Copies of this form are available from the Conservation Division, State Corporation Commission, 3830 So. Meridian (P.O. Box 17027), Wichita, Kansas 66217. Phone AC 316-522-2206. If confidential custody is desired, please note Rule 82-2-125. Drillers Logs will be on open file in the Oil and Gas Division, State Geological Survey of Kansas, Lawrence, Kansas 66044.

Operator John O. Farmer, Inc.		DESIGNATE TYPE OF COMP.: OIL, GAS, DRY HOLE, SWDW, ETC.:
Well No. #1	Lease Name Tidball	Dry Hole

S 33 T 10SR 24W <sup>EX</sup><sub>W</sub>

**WELL LOG**

Show all important zones of porosity and contents thereof; cored intervals, and all drill-stem tests, including depth interval tested, cushion used, time tool open, flowing and shut-in pressures, and recoveries.

SHOW GEOLOGICAL MARKERS, LOGS RUN,  
OR OTHER DESCRIPTIVE INFORMATION.

FORMATION DESCRIPTION, CONTENTS, ETC.	TOP	BOTTOM	NAME	DEPTH
Clay & Sand	0	45		<u>Log Tops</u>
Blue Shale	45	214		
Shale & Sand	214	1365	Anhydrite	1978 (+386)
Shale	1365	1520	Heebner	3672 (-1308)
Sand	1520	1733	Toronto	3696 (-1332)
Red Bed	1733	1974	Lansing	3712 (-1348)
Anhydrite	1974	2015	B/KC	3944 (-1580)
Shale & Shells	2015	2275		
Shale & Lime	2275	2820		
Lime & Shale	2820	2975		
Shale & Lime	2975	3255		
Lime & Shale	3255	3380		
Shale & Lime	3380	3615		
Lime & Shale	3615	3705		
Lime	3705	3955		
<p>DST #1 3725-3767  Tool open 45-45-60-45, weak blow  Rec: 186' very slight oil spot mud  IFP: 82-93  FFP: 124-145  IBHP: 1184  FBHP: 1174</p> <p>DST #2 3770-3797  Rec: 1800' watery mud  Tool open 45-45-45-45, strong blow  IFP: 124-569  FFP: 579-774  IBHP: 1081-1081</p> <p>DST #3 3855-3901  Tool open 30-30  Blow died in 15 min. flushed  Tool blow died in 10 min.  IFP: 43-43  IBHP: 62</p>				

USE ADDITIONAL SHEETS, IF NECESSARY, TO COMPLETE WELL RECORD.

Date Received	<p align="center"><i>John O. Farmer III</i>  Signature</p> <p align="center">Vice-President  Title</p> <p align="center">August 3, 1981  Date</p>
---------------	---