

WELL PLUGGING RECORD

Give All Information Completely
Make Required Affidavit
Mail or Deliver Report to:
Conservation Division
State Corporation Commission
211 No. Broadway
Wichita, Kansas

Sheridan County, Sec. 1 Twp. 10 Rge. 26W (E) (W)

Location as "NE/CNWxSWx" or footage from lines NE NE SW

Lease Owner Bennett & Roberts Oil Operations

Lease Name Flagler Well No. 1

Office Address Drawer 633, Russell, Ks.

Character of Well (completed as Oil, Gas or Dry Hole) Dry Hole

Date well completed 12/14 19 62

Application for plugging filed 12/14 verbally 19 62

Application for plugging approved 12/14 verbally 19 62


Plugging commenced 12/14 19 62

Plugging completed 12/14 19 62

Reason for abandonment of well or producing formation _____

If a producing well is abandoned, date of last production _____ 19 _____

Was permission obtained from the Conservation Division or its agents before plugging was commenced? Yes

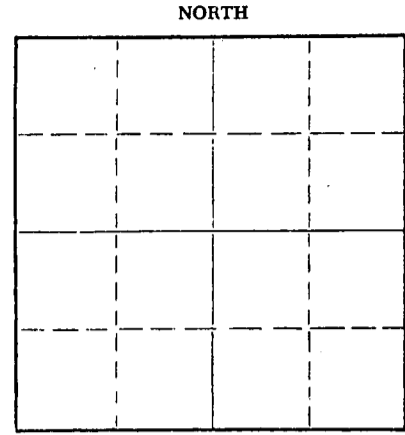

Locate well correctly on above Section Plat

Name of Conservation Agent who supervised plugging of this well Eldon Petty

Producing formation _____ Depth to top _____ Bottom _____ Total Depth of Well 4085 Feet

Show depth and thickness of all water, oil and gas formations.

OIL, GAS OR WATER RECORDS

CASING RECORD

FORMATION	CONTENT	FROM	TO	SIZE	PUT IN	PULLED OUT
				8 5/8"	216'	None

Describe in detail the manner in which the well was plugged, indicating where the mud fluid was placed and the method or methods used in introducing it into the hole. If cement or other plugs were used, state the character of same and depth placed, from _____ feet to _____ feet for each plug set.

Plug @ 550' w/20 sacks. Plug @ 200' w/20 sacks. 1/4 sack hulls @ 40' w/10 sacks cement.

RECEIVED
STATE CORPORATION COMMISSION
DEC 21 1962
12-21-1962
CONSERVATION DIVISION
Wichita, Kansas

(If additional description is necessary, use BACK of this sheet)

Name of Plugging Contractor _____
Address _____

STATE OF KANSAS, COUNTY OF RUSSELL, ss.
Donald L. Roberts (employee of owner) or (owner or operator) of the above-described well, being first duly sworn on oath, says: That I have knowledge of the facts, statements, and matters herein contained and the log of the above-described well as filed and that the same are true and correct. So help me God.

(Signature) Donald L. Roberts

Russell, Ks.
(Address)

SUBSCRIBED AND SWORN TO before me this 18th day of Dec., 19 62

Clara Hummel
Notary Public.

My commission expires 6/17/66



15-179-00199-00-00

Bennett & Roberts Oil Operations
FLAGLER #1

NE NE SW Sec. 1-10-26W
Sheridan County, Kansas

R.T.D. 4085

CONTRACTOR: Bennett & Roberts Drilling, Inc.

Commenced 12/6/62
Completed 12/14/62

Set 8 5/8" @ 216' w/150 sacks cement

Top Soil & Clay	45'
Shale & Clay	160
Shale & Shells	1995
Shale	2203
Anhydrite	2246
Shale	2270
Shale & Red Bed	2765
Shale & Lime Streaks	2915
Lime & Shale	3750
Lime	3825
Lime & Shale	3880
Lime	4085

RECEIVED
STATE CORPORATION COMMISSION

DEC 21 1962
12-21-1962
CONSERVATION DIVISION
Wichita, Kansas

STATE OF KANSAS)
RUSSELL COUNTY) SS.

I hereby certify that the above information is correct to the best of my knowledge.

BENNETT & ROBERTS DRILLING, INC.

By _____

Subscribed and sworn to before me this 18th day of December, 1962.

Clara Hummel
Notary Public

My Commission Expires 6/17/66