

Give All Information Completely  
Make Required Affidavit  
Mail or Deliver Report to:  
Conservation Division  
State Corporation Commission  
212 No. Market  
Wichita, Kansas

WELL PLUGGING RECORD

Sheridan County, Sec. 30 Twp. 10 Rge. 26 (E) W (W)

Location as "NE/CNW&SW&" or footage from lines SE NW

Lease Owner Dreiling & Hiko Bell Mining & Oil Company

Lease Name Miller Well No. 1

Office Address Route 2, Victoria, Kansas 67671

Character of Well (completed as Oil, Gas or Dry Hole) Dry Hole

Date well completed 7-13 1969

Application for plugging filed 7-13 1969

Application for plugging approved 7-13 1969

Plugging commenced 7-13 1969


Plugging completed 7-13 1969

Reason for abandonment of well or producing formation Dry Hole

If a producing well is abandoned, date of last production 19

Was permission obtained from the Conservation Division or its agents before plugging was commenced? Yes

NORTH

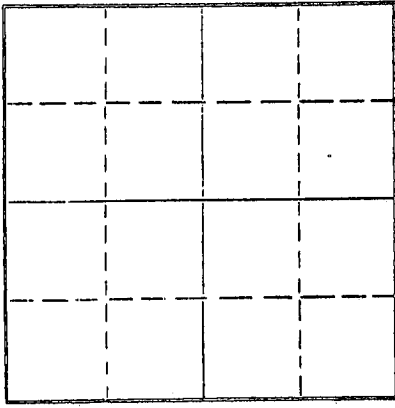

Locate well correctly on above Section Plat

Name of Conservation Agent who supervised plugging of this well W. L. Nichols

Producing formation Depth to top Bottom Total Depth of Well Feet

Show depth and thickness of all water, oil and gas formations.

OIL, GAS OR WATER RECORDS

CASING RECORD

FORMATION	CONTENT	FROM	TO	SIZE	PUT IN	PULLED OUT
Surface Pipe				8 5/8"	188'	

Describe in detail the manner in which the well was plugged, indicating where the mud fluid was placed and the method or methods used in introducing it into the hole. If cement or other plugs were used, state the character of same and depth placed, from feet to feet for each plug set.

1st. plug was set @ 1240' with 70 sacks cement

2nd. plug was set @ 215' with 20 sacks cement

3rd. plug was set @ 40' with 10 sacks cement

Cementing to bottom of cellar

RECEIVED  
STATE CORPORATION COMMISSION  
JUL 17 1969  
CONSERVATION DIVISION  
Wichita, Kansas

07-17-1969

(If additional description is necessary, use BACK of this sheet)

Name of Plugging Contractor L. J. Dreiling & Sons, Inc.

Address Route 2, Victoria, Kansas 67671

STATE OF KANSAS COUNTY OF ELLIS ss.

I, Leo F. Dreiling (employee of owner) or (owner) of the above-described

well, being first duly sworn on oath, says: That I have knowledge of the facts, statements, and matters herein contained and the log of the above-described well as filed and that the same are true and correct. So help me God.

(Signature) Leo F. Dreiling

LEO F. DREILING, ROUTE 2, VICTORIA, KANSAS 67671

(Address)

SUBSCRIBED AND SWORN TO before me this 16th day of July, 1969

My commission expires September 19, 1970

(Signature) Joseph A. Hess

JOSEPH A. HESS

Notary Public.



# L. J. DREILING AND SONS, INC.

Victoria, Kansas 67671

## WELL LOG

15-179-20220-00-00

**Company** Dreiling & Hiko Bell Mining & Oil Company  
 Route 2  
 Victoria, Kansas 67671

**Farm** Miller No. 1

**Total Depth** 4050'

**Comm.** 7-7-69 Comp. 7-13-69

**Contractor** L. J. Dreiling & Sons, Inc.  
 Victoria, Kansas 67671

**Casing Record** 188' - 8 5/8"

**Cement Record** 150 sacks cement

**Sec.** 30 **Twp.** 10 **Rng.** 26

**Location** SE NW

**County** Sheridan

**Elevation:** 2564' K. B.  
 2561' D. F.  
 2559' G. R.

**Production:** D & A

### Figures Indicate Bottom of Formations

0'	65'	Sand & Clay
65'	1145'	Shale
1145'	1165'	Sand & Shale
1165'	1780'	Shale
1780'	1940'	Sand
1940'	1985'	Shale & Redbed
1985'	2173'	Shale & Sand
2173'	2218'	Anhy.
2218'	2590'	Shale & Shells
2590'	3305'	Shale & Lime
3305'	3502'	Lime
3502'	3655'	Shale & Lime
3655'	4050'	Lime
4050'	T.D.	

RECEIVED  
 STATE CORPORATION COMMISSION  
 JUL 17 1969  
 CONSERVATION DIVISION  
 Wichita, Kansas

07-17-1969

STATE OF KANSAS)  
 )ss  
 COUNTY OF ELLIS)

I, Leo F. Dreiling, of the L. J. Dreiling & Sons, Inc., upon oath states that the above and foregoing is a true and correct copy from the Daily Drilling Report from your Miller #1.

*Leo F. Dreiling*  
 LEO F. DREILING

Subscribed and sworn to before me this 16th day of July 1969.



*Joseph A. Hess*  
 JOSEPH A. HESS NOTARY PUBLIC

My commission expires: September 19, 1970