


Give All Information Completely
Make Required Affidavit
Mail or Deliver Report to:
Conservation Division
State Corporation Commission
212 No. Market
Wichita, Kansas

WELL PLUGGING RECORD

NORTH

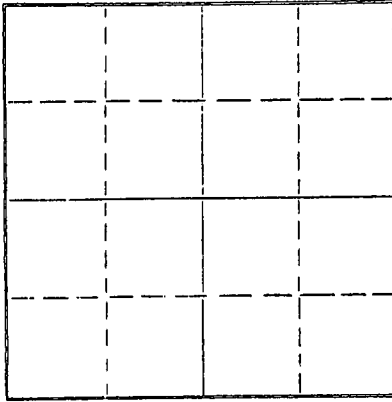

Locate well correctly on above
Section Plat

Sheridan County, Sec. 30 Twp. 10 Rge. 26 (E) W (W)
Location as "NE/CNW/SW" or footage from lines NW SW
Lease Owner Dreiling & Hiko Bell Mining & Oil Company
Lease Name Tilton Well No. 3
Office Address Route 2, Victoria, Kansas 67671
Character of Well (completed as Oil, Gas or Dry Hole) Dry Hole
Date well completed 2-9 1970
Application for plugging filed 2-9 1970
Application for plugging approved 2-9 1970
Plugging commenced 2-9 1970
Plugging completed 2-9 1970
Reason for abandonment of well or producing formation Dry Hole

If a producing well is abandoned, date of last production 19
Was permission obtained from the Conservation Division or its agents before plugging was commenced? Yes

Name of Conservation Agent who supervised plugging of this well W. L. Nichols
Producing formation _____ Depth to top _____ Bottom _____ Total Depth of Well _____ Feet
Show depth and thickness of all water, oil and gas formations.

OIL, GAS OR WATER RECORDS

CASING RECORD

| FORMATION | CONTENT | FROM | TO | SIZE | PUT IN | PULLED OUT |
|--------------|---|------|----|--------|--------|------------|
| Surface Pipe | RECEIVED STATE CORPORATION COMMISSION FEB 13 1970 CONSERVATION DIVISION Wichita, Kansas 02-13-1970 | | | 8 5/8" | 196' | |

Describe in detail the manner in which the well was plugged, indicating where the mud fluid was placed and the method or methods used in introducing it into the hole. If cement or other plugs were used, state the character of same and depth placed, from _____ feet to _____ feet for each plug set.

1st. plug was set @ 1200' with 100 cubic feet cement
2nd. Plug was set @ 245' with 20 cubic feet cement
3rd. plug was set @ 40' with 10 cubic feet cement
Cementing to bottom of cellar

(If additional description is necessary, use BACK of this sheet)


Name of Plugging Contractor L. J. Dreiling & Sons, Inc.
Address Rt. 2, Victoria, Kansas 67671

STATE OF KANSAS, COUNTY OF ELLIS, ss.
I, Leo F. Dreiling (employee of owner) or ~~(owner)~~ of the above-described well, being first duly sworn on oath, says: That I have knowledge of the facts, statements, and matters herein contained and the log of the above described well as filed and that the same are true and correct. So help me God.

(Signature) Leo F. Dreiling
LEO F. DREILING, ROUTE 2, VICTORIA, KANSAS 67671
(Address)

Subscribed AND SWORN to before me this 11th day of February, 1970

My commission expires September 19, 1970 Joseph A. Hess
JOSEPH A. HESS Notary Public.

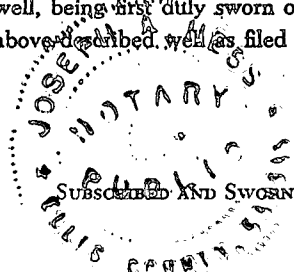

L. J. DREILING AND SONS, INC.

Victoria, Kansas 67671

15-179-20243-00-00

WELL LOG

| | | | | |
|--------------------|--|----------------------|--------------------|-------------------------------|
| Company | Dreiling & Hiko Bell Mining & Oil Co. Route 2 Victoria, Kansas 67671 | Sec. 30 | Twp. 10 | Rng. 26 |
| Farm | Tilton No. 3 | Location | NW SW | |
| Total Depth | 4013' | County | Sheridan | |
| Comm. | 2-2-70 | Comp. | 2-9-70 | Elevation: 2546' K. B. |
| Contractor | L. J. Dreiling & Sons, Inc. Victoria, Kansas 67671 | | | 2543' D. F. |
| | Casing Record | Cement Record | | 2541' G. R. |
| | 196' - 8 5/8" | 135 sacks cement | Production: | D & A |

Figures Indicate Bottom of Formations

| | | |
|-------|-------|---------------------|
| 0' | 96' | Surface Soil & Clay |
| 96' | 1651' | Shale |
| 1651' | 2149' | Shale & Shells |
| 2149' | 2205' | Anhy. |
| 2205' | 2575' | Shale & Shells |
| 2575' | 3700' | Shale & Lime |
| 3770' | 3915' | Lime |
| 3915' | 3980' | Shale & Lime |
| 3980' | 4013' | Lime |
| 4013' | T.D. | |

RECEIVED
STATE CORPORATION COMMISSION
FEB 13 1970
CONSERVATION DIVISION
Wichita, Kansas
02-13-1970

STATE OF KANSAS)
) ss
COUNTY OF ELLIS)

I, Leo F. Dreiling, of the L. J. Dreiling & Sons, Inc., upon oath states that the above and foregoing is a true and correct copy from the Daily Drilling Report from your Tilton #3.


LEO F. DREILING

Subscribed and sworn to before me this 11th day of February 1970.

JOSEPH A. HESS
NOTARY PUBLIC
WICHITA, KANSAS
My commission expires: September 19, 1970


JOSEPH A. HESS NOTARY PUBLIC