


15-179-20508-00-00

STATE OF KANSAS
STATE CORPORATION COMMISSION

WELL PLUGGING RECORD

Give All Information Completely
Make Required Affidavit
Mail or Deliver Report to
Conservation Division
State Corporation Comm.
245 North Water
Wichita, KS 67202

Sheridan County, Sec. 31 Twp. 10S Rge. 26 E/W
Location as "NE/CNW $\frac{1}{4}$ /SW $\frac{1}{4}$ " or footage from lines
SW NE SE

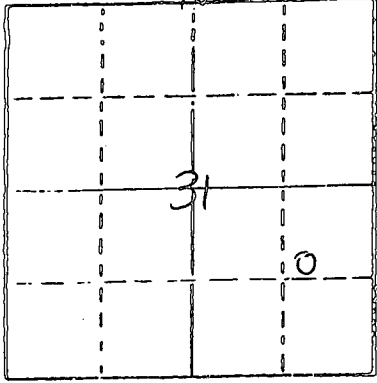

Locate well correctly on above
Section Plot

Lease Owner J. A. Allison
Lease Name George Custer Well No. 1
Office Address 300 W. Douglas, Suite 305, Wichita, Ks. 67202
Character of Well (Completed as Oil, Gas or Dry Hole)
Dry Hole

Date Well completed July 30, 1978
Application for plugging filed (verbally) July 30, 1978
Application for plugging approved (verbally) July 30, 1978
Plugging commenced July 30, 1978
Plugging completed July 30, 1978
Reason for abandonment of well or producing formation
No commercial quantity of oil or gas encountered
If a producing well is abandoned, date of last production 19

Was permission obtained from the Conservation Division or
its agents before plugging was commenced? Yes

Name of Conservation Agent who supervised plugging of this well Gilbert Balthazor
Producing formation _____ Depth to top _____ Bottom _____ Total Depth of Well 4060'
Show depth and thickness of all water, oil and gas formations.

OIL, GAS OR WATER RECORDS

CASING RECORD

FORMATION	CONTENT	FROM	TO	SIZE	PUT IN	PULLED OUT

Describe in detail the manner in which the well was plugged, indicating where the mud fluid
was placed and the method or methods used in introducing it into the hold. If cement or other
plugs were used, state the character of same and depth placed, from _____ feet to
_____ feet for each plug set.

Set 1st plug at 1000' with 70 sacks
2nd plug at 200' with 20 sacks
40' solid bridge with 10 sacks
Cemented with 50/50 posmix, 6% gel.

(If additional description is necessary, use BACK of this sheet)

Name of Plugging Contractor Abercrombie Drilling, Inc.

STATE OF KANSAS COUNTY OF SEDGWICK, ss.

Jack L. Partridge, Ass't. Sec.-Treas. (employee of owner) or (owner or operator)
of the above-described well, being first duly sworn on oath, says: That I have knowledge of
the facts, statements, and matters herein contained and the log of the above-described well
as filed and that the same are true and correct. So help me God.

(Signature)

Jack L. Partridge

801 Union Center, Wichita, Kansas 67202
(Address)

4th day of August, 1978

Sandra Richman

Notary Public.

SUBSCRIBED AND SWORN TO before me this

My commission expires July 21, 1979



AUG 07 1978
08-07-1978
CONSERVATION DIVISION
Wichita, Kansas

OPERATOR: J. A. Allison
 CONTRACTOR: Abercrombie Drilling, Inc.
 WELL NAME: George Custer #1
 LOCATION: SW NE SE Section 31-10S-26W
 Sheridan County, Kansas
 SPUD DATE: July 20, 1978
 COMPLETION DATE: July 30, 1978

0	160	Surface clay & sand
160	228	Surface sand & shale
228	1837	Shale & sand
1837	2173	Sand & shale
2173	2213	Anhydrite
2213	2410	Sand & shale
2410	2885	Shale
2885	3700	Shale & lime
3700	3865	Lime & shale
3865	3873	Lime
3873	3892	Lime & shale
3892	4060	Lime
	4060	Rotary Total Depth

Spud hole on July 20, 1978. Drilled 266' of 12 1/4" hole. Ran 5 joints of 8-5/8" surface casing. Set at 226' K.B. with 175 sacks common cement, 3% CaCl, 2% gel. Cement did circulate. Job was complete at 1:30 a.m., July 21, 1978.

T.D. 4060'. Set first plug at 1000' with 70 sacks, second plug at 200' with 20 sacks, third plug 40' solid bridge with 10 sacks. Cemented with 50/50 posmix, 6% Gel. Plug was down at 5:30 p.m., July 30, 1978. State Plugger - Gilbert Balthazor.

SAMPLE TOPS:

Anhydrite 2173'
 B/Anhydrite 2213'


STATE OF KANSAS)
) ss
 COUNTY OF SEDGWICK)

Jack L. Partridge, Assistant Secretary-Treasurer of Abercrombie Drilling, Inc., does hereby state that the above and foregoing is a true and correct copy of the log of the George Custer #1, SW NE SE Section 31-10S-26W, Sheridan County, Kansas.

ABERCROMBIE DRILLING, INC.

BY Jack L. Partridge
 Jack L. Partridge,
 Assistant Secretary-Treasurer

Subscribed and sworn to before me, a Notary Public, in and for the county and state aforesaid, as of this 4th day of August, 1978.

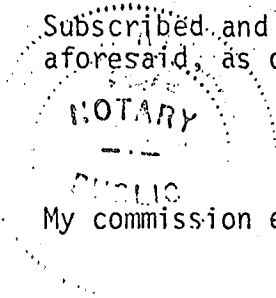

Sandra Bickman
 Sandra Bickman, Notary Public
 STATE OF KANSAS

AUG 07 1978
 08-07-1978
 Wichita, Kansas