

For KCC Use: 12-14-08
 Effective Date: _____
 District # 3
 SGA? Yes No

KANSAS CORPORATION COMMISSION
 OIL & GAS CONSERVATION DIVISION

Form C-1
 October 2007
 Form must be Typed
 Form must be Signed
 All blanks must be Filled

NOTICE OF INTENT TO DRILL

Must be approved by KCC five (5) days prior to commencing well

Expected Spud Date: 12 01 2008
 month day year

OPERATOR: License# 34027 ✓
 Name: CEP Mid-Continent LLC
 Address 1: 15 West Sixth Street, Suite 1400
 Address 2: _____
 City: Tulsa State: OK Zip: 74119 + 5415
 Contact Person: David Spitz, Engineering Manager
 Phone: (918) 877-2912, ext. 309

CONTRACTOR: License# 34126 / 33832
 Name: Smith Oilfield Services, Inc. (vert. to KOP) / Pense Bros. Drtg. (horizontal section)

Well Drilled For:	Well Class:	Type Equipment:
<input type="checkbox"/> Oil	<input type="checkbox"/> Enh Rec	<input checked="" type="checkbox"/> Infield
<input checked="" type="checkbox"/> Gas	<input type="checkbox"/> Storage	<input type="checkbox"/> Pool Ext.
	<input type="checkbox"/> Disposal	<input type="checkbox"/> Wildcat
<input type="checkbox"/> Seismic ; _____ # of Holes	<input type="checkbox"/> Other	<input type="checkbox"/> Cable
<input type="checkbox"/> Other: _____		
<input type="checkbox"/> If OWWO: old well information as follows:		
Operator: _____		
Well Name: _____		
Original Completion Date: _____ Original Total Depth: _____		

Directional, Deviated or Horizontal wellbore? Yes No
 If Yes, true vertical depth: 796'
 Bottom Hole Location: 2.488' FNL, 1.604' FEL in NE/4 Sec. 22, T33S, R16E
 KCC DKT #: C9-CONS-071-CHOR

Spot Description:
 SW - SE - SE Sec. 22 Twp. 33 S. R. 16 E W
 (0/0/0) 330 feet from N / S Line of Section
1,170 feet from E / W Line of Section
 Is SECTION: Regular Irregular?

(Note: Locate well on the Section Plat on reverse side)
 County: Montgomery
 Lease Name: FELTS Well #: 22-15
 Field Name: Cherokee Basin Coal Area
 Is this a Prorated / Spaced Field? Yes No
 Target Formation(s): Weir-Pitt
 Nearest Lease or unit boundary line (in footage): 330'
 Ground Surface Elevation: 745' feet MSL
 Water well within one-quarter mile: Yes No
 Public water supply well within one mile: Yes No
 Depth to bottom of fresh water: N/A / 100
 Depth to bottom of usable water: N/A / 150
 Surface Pipe by Alternate: I II
 Length of Surface Pipe Planned to be set: 20' est.
 Length of Conductor Pipe (if any): None
 Projected Total Depth: 3,163'
 Formation at Total Depth: Weir-Pitt
 Water Source for Drilling Operations:
 Well Farm Pond Other: City
 DWR Permit #: _____
 (Note: Apply for Permit with DWR)
 Will Cores be taken? Yes No
 If Yes, proposed zone: _____

AFFIDAVIT

The undersigned hereby affirms that the drilling, completion and eventual plugging of this well will comply with K.S.A. 55 et. seq.
 It is agreed that the following minimum requirements will be met:

RECEIVED
 KANSAS CORPORATION COMMISSION

NOV 10 2008

1. Notify the appropriate district office **prior** to spudding of well;
2. A copy of the approved notice of intent to drill **shall be** posted on each drilling rig;
3. The minimum amount of surface pipe as specified below **shall be set** by circulating cement to the top; in all cases surface pipe **shall be set** through all unconsolidated materials plus a minimum of 20 feet into the underlying formation.
4. If the well is dry hole, an agreement between the operator and the district office on **plug length and placement is necessary prior to plugging**;
5. The appropriate district office will be notified before well is either plugged or production casing is cemented in;
6. If an ALTERNATE II COMPLETION, production pipe shall be cemented from below any usable water to surface within **120 DAYS** of spud date. Or pursuant to Appendix "B" - Eastern Kansas surface casing order #133,891-C, which applies to the KCC District 3 area, alternate II cementing must be completed within 30 days of the spud date or the well shall be plugged. **In all cases, NOTIFY district office** prior to any cementing.

I hereby certify that the statements made herein are true and correct to the best of my knowledge and belief.

Date: 11-6-08 Signature of Operator or Agent: _____ Title: Engineering Manager

For KCC Use ONLY
 API # 15 - 125-31846-01-00
 Conductor pipe required None feet
 Minimum surface pipe required 20 feet per ALT. I II
 Approved by: lms 12-9-08
 This authorization expires: 12-9-09
 (This authorization void if drilling not started within 12 months of approval date.)
 Spud date: _____ Agent: _____

- Remember to:**
- File Drill Pit Application (form CDP-1) with Intent to Drill;
 - File Completion Form ACO-1 within 120 days of spud date;
 - File acreage attribution plat according to field proration orders;
 - Notify appropriate district office 48 hours prior to workover or re-entry;
 - Submit plugging report (CP-4) after plugging is completed (within 60 days);
 - Obtain written approval before disposing or injecting salt water.
 - If this permit has expired (See: authorized expiration date) please check the box below and return to the address below.
- Well Not Drilled - Permit Expired Date: _____
 Signature of Operator or Agent: _____

22
 33
 16
 E
 W

IN ALL CASES PLOT THE INTENDED WELL ON THE PLAT BELOW

Plat of acreage attributable to a well in a prorated or spaced field

If the intended well is in a prorated or spaced field, please fully complete this side of the form. If the intended well is in a prorated or spaced field complete the plat below showing that the well will be properly located in relationship to other wells producing from the common source of supply. Please show all the wells and within 1 mile of the boundaries of the proposed acreage attribution unit for gas wells and within 1/2 mile of the boundaries of the proposed acreage attribution unit for oil wells.

API No. 15 - 125-31846-01-00

Operator: CEP Mid-Continent LLC

Lease: FELTS

Well Number: 22-15

Field: Cherokee Basin Coal Area

Number of Acres attributable to well: _____

QTR/QTR/QTR/QTR of acreage: _____ - SW - SE - SE

Location of Well: County: Montgomery

330 feet from N / S Line of Section

1,170 feet from E / W Line of Section

Sec. 22 Twp. 33 S. R. 16 E W

Is Section: Regular or Irregular


If Section is Irregular, locate well from nearest corner boundary.

Section corner used: NE NW SE SW

PLAT

(Show location of the well and shade attributable acreage for prorated or spaced wells.)

(Show footage to the nearest lease or unit boundary line.)

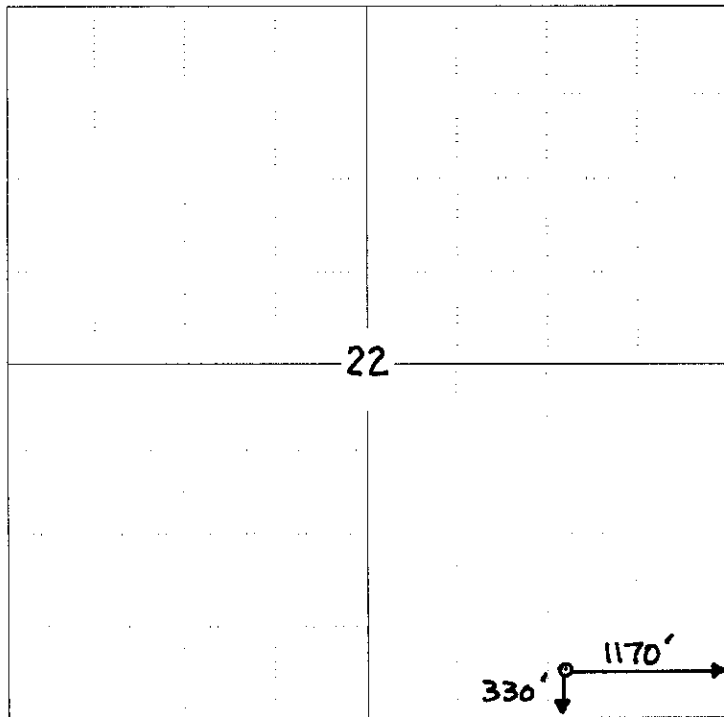


NOTE: In all cases locate the spot of the proposed drilling location.

RECEIVED
KANSAS CORPORATION COMMISSION

NOV 10 2008

CONSERVATION DIVISION
WICHITA, KS

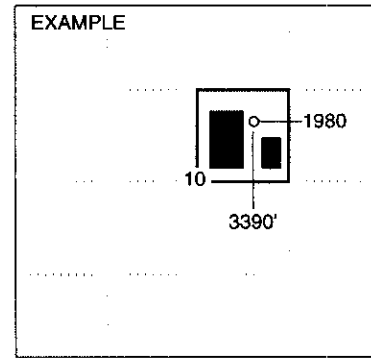


In plotting the proposed location of the well, you must show:

1. The manner in which you are using the depicted plat by identifying section lines, i.e. 1 section, 1 section with 8 surrounding sections, 4 sections, etc.
2. The distance of the proposed drilling location from the south / north and east / west outside section lines.
3. The distance to the nearest lease or unit boundary line (in footage).
4. If proposed location is located within a prorated or spaced field a certificate of acreage attribution plat must be attached: (CO-7 for oil wells; CG-8 for gas wells).

**KANSAS CORPORATION COMMISSION
OIL & GAS CONSERVATION DIVISION
APPLICATION FOR SURFACE PIT**

Form CDP-1
April 2004
Form must be Typed

Submit in Duplicate

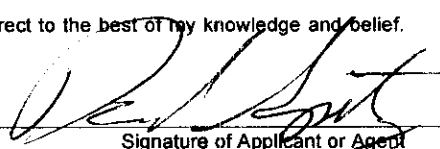Operator Name: CEP Mid-Continent LLC		License Number: 34027
Operator Address: 15 West Sixth Street, Suite 1400		Tulsa OK 74119
Contact Person: David Spitz, Engineering Manager		Phone Number: (918) 877-2912, ext. 309
Lease Name & Well No.: FELTS 22-15		Pit Location (QQQQ): _____ SW _____ SE _____ SE Sec. <u>22</u> Twp. <u>33</u> R. <u>16</u> <input checked="" type="checkbox"/> East <input type="checkbox"/> West <u>330</u> Feet from <input type="checkbox"/> North / <input checked="" type="checkbox"/> South Line of Section <u>1,170</u> Feet from <input checked="" type="checkbox"/> East / <input type="checkbox"/> West Line of Section Montgomery County
Type of Pit: <input type="checkbox"/> Emergency Pit <input type="checkbox"/> Burn Pit <input type="checkbox"/> Settling Pit <input checked="" type="checkbox"/> Drilling Pit <input type="checkbox"/> Workover Pit <input type="checkbox"/> Haul-Off Pit <small>(If WP Supply API No. or Year Drilled)</small>	Pit is: <input checked="" type="checkbox"/> Proposed <input type="checkbox"/> Existing If Existing, date constructed: _____ Pit capacity: 1,710 (bbbls)	
Is the pit located in a Sensitive Ground Water Area? <input checked="" type="checkbox"/> Yes <input type="checkbox"/> No		Chloride concentration: _____ mg/l <small>(For Emergency Pits and Settling Pits only)</small>
Is the bottom below ground level? <input checked="" type="checkbox"/> Yes <input type="checkbox"/> No	Artificial Liner? <input type="checkbox"/> Yes <input checked="" type="checkbox"/> No	How is the pit lined if a plastic liner is not used? Native clays
Pit dimensions (all but working pits): <u>30</u> Length (feet) <u>40</u> Width (feet) <input type="checkbox"/> N/A: Steel Pits Depth from ground level to deepest point: <u>8</u> (feet) <input type="checkbox"/> No Pit		
If the pit is lined give a brief description of the liner material, thickness and installation procedure. N/A	Describe procedures for periodic maintenance and determining liner integrity, including any special monitoring. N/A	
Distance to nearest water well within one-mile of pit <u>N/A</u> ⁵²⁶⁰ feet Depth of water well <u>123</u> feet	Depth to shallowest fresh water <u>22</u> feet. Source of information: <input type="checkbox"/> measured <input type="checkbox"/> well owner <input type="checkbox"/> electric log <input checked="" type="checkbox"/> KDWR	
Emergency, Settling and Burn Pits ONLY: Producing Formation: _____ Number of producing wells on lease: _____ Barrels of fluid produced daily: _____ Does the slope from the tank battery allow all spilled fluids to flow into the pit? <input type="checkbox"/> Yes <input type="checkbox"/> No	Drilling, Workover and Haul-Off Pits ONLY: Type of material utilized in drilling/workover: <u>Fresh water</u> Number of working pits to be utilized: <u>1</u> Abandonment procedure: <u>Air dried and backfilled</u> Drill pits must be closed within 365 days of spud date.	
I hereby certify that the above statements are true and correct to the best of my knowledge and belief.		RECEIVED KANSAS CORPORATION COMMISSION
<u>11-6-08</u> Date	 Signature of Applicant or Agent	NOV 10 2008 CONSERVATION DIVISION WICHITA, KS
KCC OFFICE USE ONLY		
Steel Pit <input type="checkbox"/> RFAC <input checked="" type="checkbox"/> RFAS <input type="checkbox"/>		
Date Received: <u>11/10/08</u> Permit Number: _____ Permit Date: <u>12/8/08</u> Lease Inspection: <input checked="" type="checkbox"/> Yes <input type="checkbox"/> No		

15-125-31846-01-00

Mail to: KCC - Conservation Division, 130 S. Market - Room 2078, Wichita, Kansas 67202



Kathleen Sebelius, Governor
Thomas E. Wright, Chairman
Michael C. Moffet, Commissioner
Joseph F. Harkins, Commissioner

December 8, 2008

CEP Mid Continent LLC
15 West 6th St Ste 1400
Tulsa, OK 74119-5415

RE: Drilling Pit Application
Knisley Lease Well No. 22-15
SE/4 Sec. 22-33S-16E
Montgomery County, Kansas

Dear Sir or Madam:

District staff has inspected the above referenced location and has determined that the reserve pit shall be constructed **without slots**, the bottom shall be flat and reasonably level, and the free fluids must be removed. The fluids are to be removed from the reserve pit as soon as practical after drilling operations have ceased.

If production casing is set all completion fluids shall be removed from the working pits daily. NO completion fluids or non-exempt wastes shall be placed in the reserve pit.

The fluids should be taken to an authorized disposal well. Please call the District Office at (620) 432-2300 when the fluids have been removed. Please file form CDP-5 (August 2004), Exploration and Production Waste Transfer, within 30 days of fluid removal. Conservation division forms are available through our office and on the KCC web site: www.kcc.state.ks.us/conservation/forms.

A copy of this letter should be posted in the doghouse along with the approved Intent to Drill.

If you have any questions or concerns please feel free to contact the undersigned at the above address.

Sincerely,

Kathy Haynes
Environmental Protection and Remediation Department

cc: File


15-25-31846-01-00

RECEIVED
KANSAS CORPORATION COMMISSION

NOV 10 2008


CONSERVATION DIVISION
WICHITA, KS

**WELL LOCATION
STANDARD SECTION 22,
T-33-S, R-16-E, P.M.
MONTGOMERY COUNTY, KANSAS**

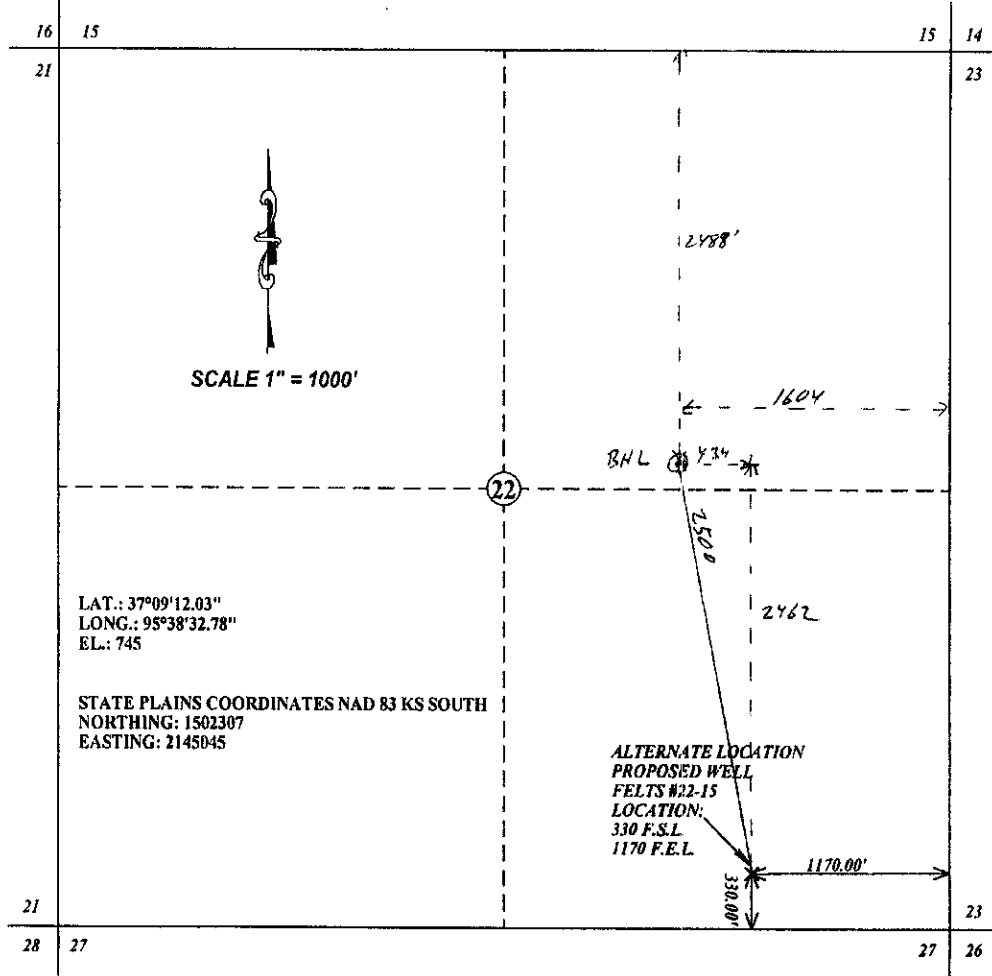

This well location represents a well site and does not represent a boundary survey. This site was located in accordance with the Laws of the State of Kansas and this sketch shows the results of this well location. This well location has been very carefully located on the ground according to the latest survey records, maps and topos available to us, but its accuracy is not guaranteed. Review this well location and notify Commercial Land Surveys, Inc., immediately of any discrepancy.

1/4" = 67'


SCALE 1" = 1000' / 066'	DATE 09/11/08	 <p>580-759-3886 RT 2 BOX 191B STRATFORD, OK 74872</p>	FOR: CEP MID-CONTINENT, LLC 15 WEST 6TH STREET 14TH FLOOR TUSLA, OK 74119-5415
SHEET 1 OF 1	DATE REVISED 10/17/08		ORDERED BY: PENNEY SNYDER
DRAWN BY: D.L.	PROJECT# CLS-08-3282		
CHECKED BY: F.W.D	DATE OF SURVEY 09/10/08		

Proposed: RJT 11/5/08

15-125-3846-01-00

Proposed Well Felts 22-15 Wellbore Diagram
 Proposed Surface Loc: SE/4 Sec 22 T33S - R16E - Kanmap
 Proposed Surface Loc: 330' FSL, 1,170' FEL, ELEV 745'
 Proposed Bottomhole Loc: NE/4 Sec 22 T33S - R16E
 Proposed Bottomhole Loc, Start of Target: 611' FSL, 1,220' FEL Sec 22
 Proposed Bottomhole Loc, End of Target: 2,488' FNL, 1,604' FEL Sec 22 Azim 350°
 Proposed Vertical Section: 2,500'
 Proposed Lateral Length: 2,215'

	Size	Wt	# jts.	Length	MD	TVD
Surface Casing	7"	17#	NA	40.00	40.00	40
Production Casing	4.5"	10.5#	25	796.00	796.00	747
Stage Tool	4.5"			2.00	798.00	749
Ann. Csg. Pkr	4.5"			26.00	824.00	761
Production Casing	4.5"	10.5#	2	62.00	886.00	777
4.5" x 3.5" X-over				1.00	887.00	778
Blank Liner	3.5"	9.3#	2	62.00	949.00	788
Preperf Liner	3.5"	9.3#	68	2,180.00	3,129.00	794
tapered perf liner	3.5"	9.3#	1	31.00	3,160.00	794

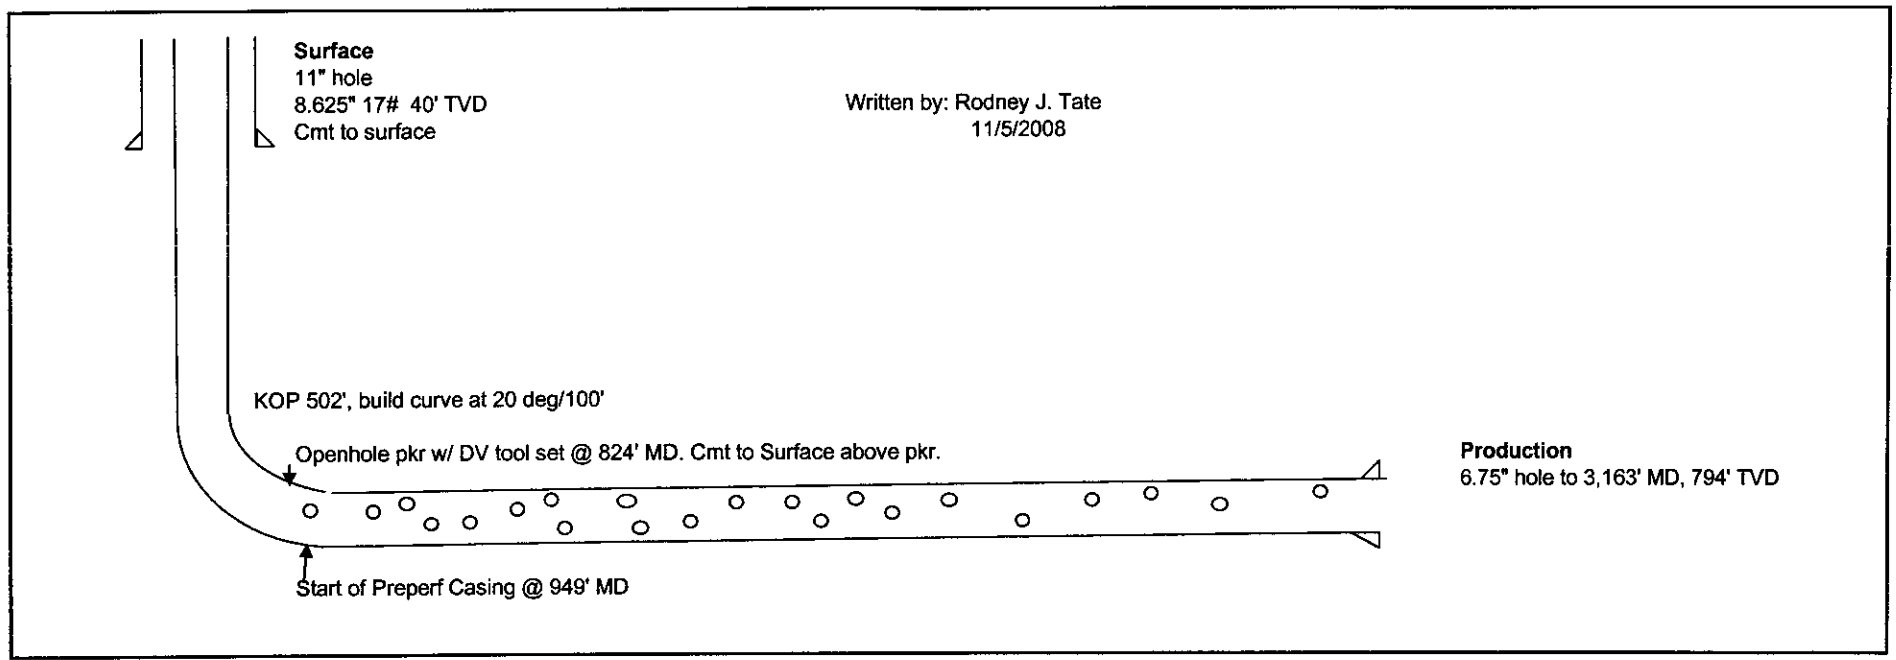

Felts 22-15 Drilling Procedure

Written by: Rodney J. Tate 11/05/08

Constellation Energy Partners Mid-Continent, LLC
SE/4 Section 22 T33S – R16E, Montgomery Co., KS
Surface Location: 330' FSL, 1,170' FEL

15-125-31846-01-00

Objective:

Drill a horizontal lateral into the Weir-Pitt coal. Run 3.5" casing with the pre-perforated casing in the lateral along with a external cement packer above the lateral. Circulate cement above the ECP to surface. Run tubing, rods and pump and put on production.

- 1.) MIRU drilling rig. Drill approx 40' of 11" hole. Run 8.625" 17# casing. Circulate cement to surface. (footage contract).
- 2.) Drill to 499.5' MD with 6.75" hammer bit. Load hole with produce water and wait for directional rig and services.
- 3.) PU 2 or 3 type 6.25" bit, near bit gamma, motor, float sub, UBHO, NMDC, 3.5" IF DP. TIH.
- 4.) Drill a 6.75" hole, 350° azimuth at a build rate approximately 20.00°/100' to an approximate TVD of 786', 948.5' MD or at an inclination of 89.8°. Hold angle until Weir-Pitt coal is found. Drill hole with fresh water, and polymer sweeps as needed. TOH with build assembly.
- 5.) TIH with hold assembly. Drill approximately 2,214.6' of coal or more if able. Drill hole with fresh water, and polymer sweeps as needed. Estimated TD is 3,163' MD and 793.7' TVD. TOH. LD directional tools and DP.
- 6.) PU 3.5" 9.3# pre-perforated casing with turn down collars, bottom joint should be tapered, ECP, 4.5" 10.5# above ECP to surface. Inflate ECP. Open port hole above ECP and cmt to surface. Release drilling rig.

Scientific Drilling International Planning Report

15-125-31846-01-00

Company: Constellation Energy Partners	Date: 11/4/2008	Time: 09:15:40	Page: 1								
Field: Montgomery County, KS	Co-ordinate(NE) Reference: Well: Felts 22-15, True North										
Site: Section 22 - 33S - 16E	Vertical (TVD) Reference: Felts 22-15 750.0										
Well: Felts 22-15	Section (VS) Reference: Well (0.00N,0.00E,350.00Azi)										
Wellpath: Original Wellpath	Plan: Plan #1										
Field: Montgomery County, KS Montgomery County, KS											
Map System: US State Plane Coordinate System 1983		Map Zone: Kansas, Southern Zone									
Geo Datum: GRS 1980		Coordinate System: Well Centre									
Sys Datum: Mean Sea Level		Geomagnetic Model: igrf2005									
Site: Section 22 - 33S - 16E Sec 22-33S-16E											
Site Position:	Northing: ft	Latitude:									
From: Lease Line	Easting: ft	Longitude:									
Position Uncertainty: 0.0 ft		North Reference: True									
Ground Level: 0.0 ft		Grid Convergence: 1.76 deg									
Well: Felts 22-15 Felts 22-15											
		Slot Name:									
Well Position: +N/-S 0.0 ft	Northing: 1502306.17 ft	Latitude: 37 9 12.040 N									
+E/-W 0.0 ft	Easting: 2144898.69 ft	Longitude: 95 38 34.640 W									
Position Uncertainty: 0.0 ft											
Wellpath: Original Wellpath Original Wellpath Felts 22-15											
Current Datum: Felts 22-15	Height 750.0 ft	Drilled From: Surface									
Magnetic Data: 10/8/2008		Tie-on Depth: 0.0 ft									
Field Strength: 52432 nT		Above System Datum: Mean Sea Level									
Vertical Section: Depth From (TVD)	+N/-S ft	Declination: 3.46 deg									
ft	ft	Mag Dip Angle: 65.73 deg									
0.0	0.0	+E/-W ft	Direction deg								
		0.0	350.00								
Plan: Plan #1 Felts 22-15 SHL: 330 FSL 1320 FEL											
Principal: Yes		Date Composed: 10/8/2008									
		Version: 1									
		Tied-to: From Surface									
Plan Section Information											
MD	Incl	Azim	TVD	+N/-S	+E/-W	DLS	Build	Turn	TFO	Target	
ft	deg	deg	ft	ft	ft	deg/100ft	deg/100ft	deg/100ft	deg		
0.0	0.00	350.00	0.0	0.0	0.0	0.00	0.00	0.00	0.00		
499.5	0.00	350.00	499.5	0.0	0.0	0.00	0.00	0.00	0.00		
948.5	89.80	350.00	786.0	281.1	-49.6	20.00	20.00	0.00	350.00		
3163.1	89.80	350.00	793.7	2462.0	-434.1	0.00	0.00	0.00	0.00		
Section 1 : Start Hold											
MD	Incl	Azim	TVD	+N/-S	+E/-W	VS	DLS	Build	Turn	TFO	
ft	deg	deg	ft	ft	ft	ft	deg/100ft	deg/100ft	deg/100ft	deg	
0.0	0.00	350.00	0.0	0.0	0.0	0.0	0.00	0.00	0.00	0.00	
499.5	0.00	350.00	499.5	0.0	0.0	0.0	0.00	0.00	0.00	350.00	
Section 2 : Start Build 20.00											
MD	Incl	Azim	TVD	+N/-S	+E/-W	VS	DLS	Build	Turn	TFO	
ft	deg	deg	ft	ft	ft	ft	deg/100ft	deg/100ft	deg/100ft	deg	
512.0	2.50	350.00	512.0	0.3	0.0	0.3	20.00	20.00	0.00	0.00	
525.0	5.10	350.00	525.0	1.1	-0.2	1.1	20.00	20.00	0.00	0.00	
548.2	9.75	350.00	548.0	4.1	-0.7	4.1	20.00	20.00	0.00	0.00	
550.0	10.10	350.00	549.7	4.4	-0.8	4.4	20.00	20.00	0.00	0.00	
575.0	15.10	350.00	574.1	9.7	-1.7	9.9	20.00	20.00	0.00	0.00	
579.1	15.91	350.00	578.0	10.8	-1.9	11.0	20.00	20.00	0.00	0.00	
600.0	20.10	350.00	598.0	17.2	-3.0	17.4	20.00	20.00	0.00	0.00	
608.7	21.83	350.00	606.1	20.2	-3.6	20.6	20.00	20.00	0.00	0.00	
619.6	24.01	350.00	616.1	24.4	-4.3	24.8	20.00	20.00	0.00	0.00	
625.0	25.10	350.00	621.0	26.6	-4.7	27.0	20.00	20.00	0.00	0.00	
643.1	28.71	350.00	637.1	34.7	-6.1	35.2	20.00	20.00	0.00	0.00	
650.0	30.10	350.00	643.2	38.0	-6.7	38.6	20.00	20.00	0.00	0.00	
675.0	35.10	350.00	664.2	51.3	-9.0	52.1	20.00	20.00	0.00	0.00	

Scientific Drilling International Planning Report

15-125-31846-0100

Company: Constellation Energy Partners				Date: 11/4/2008		Time: 09:15:40		Page: 2		
Field: Montgomery County, KS				Co-ordinate(NE) Reference:		Well: Felts 22-15, True North				
Site: Section 22 - 33S - 16E				Vertical (TVD) Reference:		Felts 22-15 750.0				
Well: Felts 22-15				Section (VS) Reference:		Well (0.00N,0.00E,350.00Azi)				
Wellpath: Original Wellpath				Plan:		Plan #1				
Section 2 : Start Build 20.00										
MD ft	Incl deg	Azim deg	TVD ft	+N/-S ft	+E/-W ft	VS ft	DLS deg/100ft	Build deg/100ft	Turn deg/100ft	TFO deg
696.4	39.37	350.00	681.2	64.0	-11.3	65.0	20.00	20.00	0.00	0.00
700.0	40.10	350.00	684.0	66.3	-11.7	67.3	20.00	20.00	0.00	0.00
725.0	45.10	350.00	702.4	83.0	-14.6	84.2	20.00	20.00	0.00	0.00
750.0	50.10	350.00	719.3	101.1	-17.8	102.7	20.00	20.00	0.00	0.00
775.0	55.10	350.00	734.5	120.7	-21.3	122.6	20.00	20.00	0.00	0.00
776.7	55.43	350.00	735.4	122.1	-21.5	123.9	20.00	20.00	0.00	0.00
800.0	60.10	350.00	747.9	141.5	-24.9	143.7	20.00	20.00	0.00	0.00
825.0	65.10	350.00	759.4	163.3	-28.8	165.8	20.00	20.00	0.00	0.00
850.0	70.10	350.00	768.9	186.1	-32.8	188.9	20.00	20.00	0.00	0.00
875.0	75.10	350.00	776.4	209.6	-37.0	212.8	20.00	20.00	0.00	0.00
900.0	80.10	350.00	781.7	233.6	-41.2	237.2	20.00	20.00	0.00	0.00
925.0	85.10	350.00	785.0	258.0	-45.5	262.0	20.00	20.00	0.00	0.00
947.1	89.53	350.00	786.0	279.8	-49.3	284.1	20.00	20.00	0.00	0.00
948.5	89.80	350.00	786.0	281.1	-49.6	285.5	20.00	20.00	0.00	0.00
Section 3 : Start Hold										
MD ft	Incl deg	Azim deg	TVD ft	+N/-S ft	+E/-W ft	VS ft	DLS deg/100ft	Build deg/100ft	Turn deg/100ft	TFO deg
1000.0	89.80	350.00	786.2	331.8	-58.5	337.0	0.00	0.00	0.00	0.00
1100.0	89.80	350.00	786.5	430.3	-75.9	437.0	0.00	0.00	0.00	0.00
1200.0	89.80	350.00	786.9	528.8	-93.2	537.0	0.00	0.00	0.00	0.00
1300.0	89.80	350.00	787.2	627.3	-110.6	637.0	0.00	0.00	0.00	0.00
1400.0	89.80	350.00	787.6	725.8	-128.0	737.0	0.00	0.00	0.00	0.00
1500.0	89.80	350.00	787.9	824.2	-145.3	837.0	0.00	0.00	0.00	0.00
1600.0	89.80	350.00	788.3	922.7	-162.7	937.0	0.00	0.00	0.00	0.00
1700.0	89.80	350.00	788.6	1021.2	-180.1	1037.0	0.00	0.00	0.00	0.00
1800.0	89.80	350.00	789.0	1119.7	-197.4	1137.0	0.00	0.00	0.00	0.00
1900.0	89.80	350.00	789.3	1218.2	-214.8	1237.0	0.00	0.00	0.00	0.00
2000.0	89.80	350.00	789.7	1316.6	-232.2	1336.9	0.00	0.00	0.00	0.00
2100.0	89.80	350.00	790.0	1415.1	-249.5	1436.9	0.00	0.00	0.00	0.00
2200.0	89.80	350.00	790.4	1513.6	-266.9	1536.9	0.00	0.00	0.00	0.00
2300.0	89.80	350.00	790.7	1612.1	-284.3	1636.9	0.00	0.00	0.00	0.00
2400.0	89.80	350.00	791.1	1710.6	-301.6	1736.9	0.00	0.00	0.00	0.00
2500.0	89.80	350.00	791.4	1809.0	-319.0	1836.9	0.00	0.00	0.00	0.00
2600.0	89.80	350.00	791.8	1907.5	-336.3	1936.9	0.00	0.00	0.00	0.00
2700.0	89.80	350.00	792.1	2006.0	-353.7	2036.9	0.00	0.00	0.00	0.00
2800.0	89.80	350.00	792.5	2104.5	-371.1	2136.9	0.00	0.00	0.00	0.00
2900.0	89.80	350.00	792.8	2203.0	-388.4	2236.9	0.00	0.00	0.00	0.00
3000.0	89.80	350.00	793.2	2301.4	-405.8	2336.9	0.00	0.00	0.00	0.00
3100.0	89.80	350.00	793.5	2399.9	-423.2	2436.9	0.00	0.00	0.00	0.00
3163.1	89.80	350.00	793.7	2462.0	-434.1	2500.0	0.00	0.00	0.00	0.00
Survey										
MD ft	Incl deg	Azim deg	TVD ft	+N/-S ft	+E/-W ft	VS ft	DLS deg/100ft	Build deg/100ft	Turn deg/100ft	Tool/Comment
499.5	0.00	350.00	499.5	0.0	0.0	0.0	0.00	0.00	0.00	
512.0	2.50	350.00	512.0	0.3	0.0	0.3	20.00	20.00	0.00	Higginsville
525.0	5.10	350.00	525.0	1.1	-0.2	1.1	20.00	20.00	0.00	
548.2	9.75	350.00	548.0	4.1	-0.7	4.1	20.00	20.00	0.00	L. Osage
550.0	10.10	350.00	549.7	4.4	-0.8	4.4	20.00	20.00	0.00	
575.0	15.10	350.00	574.1	9.7	-1.7	9.9	20.00	20.00	0.00	
579.1	15.91	350.00	578.0	10.8	-1.9	11.0	20.00	20.00	0.00	Mulky
600.0	20.10	350.00	598.0	17.2	-3.0	17.4	20.00	20.00	0.00	
608.7	21.83	350.00	606.1	20.2	-3.6	20.6	20.00	20.00	0.00	IP
619.6	24.01	350.00	616.1	24.4	-4.3	24.8	20.00	20.00	0.00	Bev
625.0	25.10	350.00	621.0	26.6	-4.7	27.0	20.00	20.00	0.00	
643.1	28.71	350.00	637.1	34.7	-6.1	35.2	20.00	20.00	0.00	Cr
650.0	30.10	350.00	643.2	38.0	-6.7	38.6	20.00	20.00	0.00	
675.0	35.10	350.00	664.2	51.3	-9.0	52.1	20.00	20.00	0.00	
696.4	39.37	350.00	681.2	64.0	-11.3	65.0	20.00	20.00	0.00	Min

Scientific Drilling International Planning Report

15-125-31846-01-00

Company: Constellation Energy Partners
Field: Montgomery County, KS
Site: Section 22 - 33S - 16E
Well: Felts 22-15
Wellpath: Original Wellpath

Date: 11/4/2008
Co-ordinate(NE) Reference: Well: Felts 22-15, True North
Vertical (TVD) Reference: Felts 22-15 750.0
Section (VS) Reference: Well (0.00N,0.00E,350.00Azi)
Plan: Plan #1

Page: 3

Survey

MD ft	Incl deg	Azim deg	TVD ft	+N/-S ft	+E/-W ft	VS ft	DLS deg/100ft	Build deg/100ft	Turn deg/100ft	Tool/Comment
700.0	40.10	350.00	684.0	66.3	-11.7	67.3	20.00	20.00	0.00	
725.0	45.10	350.00	702.4	83.0	-14.6	84.2	20.00	20.00	0.00	
750.0	50.10	350.00	719.3	101.1	-17.8	102.7	20.00	20.00	0.00	
775.0	55.10	350.00	734.5	120.7	-21.3	122.6	20.00	20.00	0.00	
776.7	55.43	350.00	735.4	122.1	-21.5	123.9	20.00	20.00	0.00	Tebo
800.0	60.10	350.00	747.9	141.5	-24.9	143.7	20.00	20.00	0.00	
825.0	65.10	350.00	759.4	163.3	-28.8	165.8	20.00	20.00	0.00	
850.0	70.10	350.00	768.9	186.1	-32.8	188.9	20.00	20.00	0.00	
875.0	75.10	350.00	776.4	209.6	-37.0	212.8	20.00	20.00	0.00	
900.0	80.10	350.00	781.7	233.6	-41.2	237.2	20.00	20.00	0.00	
925.0	85.10	350.00	785.0	258.0	-45.5	262.0	20.00	20.00	0.00	
947.1	89.53	350.00	786.0	279.8	-49.3	284.1	20.00	20.00	0.00	Weir Pitt
948.5	89.80	350.00	786.0	281.1	-49.6	285.5	20.00	20.00	0.00	
1000.0	89.80	350.00	786.2	331.8	-58.5	337.0	0.00	0.00	0.00	
1100.0	89.80	350.00	786.5	430.3	-75.9	437.0	0.00	0.00	0.00	
1200.0	89.80	350.00	786.9	528.8	-93.2	537.0	0.00	0.00	0.00	
1300.0	89.80	350.00	787.2	627.3	-110.8	637.0	0.00	0.00	0.00	
1400.0	89.80	350.00	787.6	725.8	-128.0	737.0	0.00	0.00	0.00	
1500.0	89.80	350.00	787.9	824.2	-145.3	837.0	0.00	0.00	0.00	
1600.0	89.80	350.00	788.3	922.7	-162.7	937.0	0.00	0.00	0.00	
1700.0	89.80	350.00	788.6	1021.2	-180.1	1037.0	0.00	0.00	0.00	
1800.0	89.80	350.00	789.0	1119.7	-197.4	1137.0	0.00	0.00	0.00	
1900.0	89.80	350.00	789.3	1218.2	-214.8	1237.0	0.00	0.00	0.00	
2000.0	89.80	350.00	789.7	1316.6	-232.2	1336.9	0.00	0.00	0.00	
2100.0	89.80	350.00	790.0	1415.1	-249.5	1436.9	0.00	0.00	0.00	
2200.0	89.80	350.00	790.4	1513.6	-266.9	1536.9	0.00	0.00	0.00	
2300.0	89.80	350.00	790.7	1612.1	-284.3	1636.9	0.00	0.00	0.00	
2400.0	89.80	350.00	791.1	1710.6	-301.6	1736.9	0.00	0.00	0.00	
2500.0	89.80	350.00	791.4	1809.0	-319.0	1836.9	0.00	0.00	0.00	
2600.0	89.80	350.00	791.8	1907.5	-336.3	1936.9	0.00	0.00	0.00	
2700.0	89.80	350.00	792.1	2006.0	-353.7	2036.9	0.00	0.00	0.00	
2800.0	89.80	350.00	792.5	2104.5	-371.1	2136.9	0.00	0.00	0.00	
2900.0	89.80	350.00	792.8	2203.0	-388.4	2236.9	0.00	0.00	0.00	
3000.0	89.80	350.00	793.2	2301.4	-405.8	2336.9	0.00	0.00	0.00	
3100.0	89.80	350.00	793.5	2399.9	-423.2	2436.9	0.00	0.00	0.00	
3163.1	89.80	350.00	793.7	2462.0	-434.1	2500.0	0.00	0.00	0.00	

Formations

MD ft	TVD ft	Formations	Lithology	Dip Angle deg	Dip Direction deg
512.0	512.0	Higginsville		0.20	350.00
548.2	548.0	L Osage		0.20	350.00
579.1	578.0	Mulky		0.20	350.00
608.7	606.1	IP		0.20	350.00
619.6	616.1	Bev		0.20	350.00
643.1	637.1	Cr		0.20	350.00
696.4	681.2	Min		0.20	350.00
776.7	735.4	Tebo		0.20	350.00
947.1	786.0	Weir Pitt		0.20	350.00


1512531846-0100



Scientific Drilling

Constellation Energy Partners

Field: Montgomery County, KS
 Site: Section 22 - 335 - 16E
 Well: Fels 22-15
 Wellpath: Original Wellpath
 Plan: Plan #1

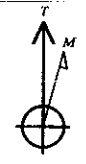

Azimuths to True North
 Magnetic North: 3.46°
 Magnetic Field
 Strength: 52432nT
 Dip Angle: 65.73°
 Date: 10/8/2008
 Model: igrf2005

SECTION DETAILS

Sec	MD	Inc	Azi	TVD	+N-S	+E-W	DLeg	TFace	VSec	Target
1	0.0	0.00	350.00	0.0	0.0	0.0	0.00	0.00	0.0	
2	499.5	0.00	350.00	499.5	0.0	0.0	0.00	0.00	0.0	
3	948.5	89.80	350.00	786.0	281.1	-49.6	20.00	350.00	285.5	
4	3163.1	89.80	350.00	793.7	2462.0	-434.1	0.00	0.00	2500.0	

WELL PATH SUMMARY
 Original Wellpath
 Date: 10/8/2008

Sec	MD	Inc	Azi	TVD	+N-S	+E-W	DLeg	TFace	VSec	Target
1	0.0	0.00	350.00	0.0	0.0	0.0	0.00	0.00	0.0	
2	499.5	0.00	350.00	499.5	0.0	0.0	0.00	0.00	0.0	
3	948.5	89.80	350.00	786.0	281.1	-49.6	20.00	350.00	285.5	
4	3163.1	89.80	350.00	793.7	2462.0	-434.1	0.00	0.00	2500.0	

TARGET DETAILS

Name	TVD	+N-S	+E-W	Shape
TGT Fels 22-15	793.7	2462.0	-434.1	Point

FORMATION TOP DETAILS

No.	TVD Path	MD Path	Formation
1	512.0	512.0	Higginville
2	548.0	548.2	L. Orange
3	579.0	579.1	Mulky
8	735.4	776.7	Tebo
9	786.0	947.1	Weir Plat

