


15-179-20484-00-00

STATE OF KANSAS  
STATE CORPORATION COMMISSION

WELL PLUGGING RECORD

Give All Information Completely  
Make Required Affidavit  
Mail or Deliver Report to  
Conservation Division  
State Corporation Comm.  
245 North Water  
Wichita, KS 67202

Sheridan County, Sec. 15 Twp. 10S Rge. 30 E/W  
Location as "NE/CNW $\frac{1}{4}$ SW $\frac{1}{4}$ " or footage from lines  
C NW SW NE  
Lease Owner Abercrombie Drilling, Inc.  
Lease Name ALBERS Well No. 1  
Office Address 801 Union Center, Wichita, Kansas 67202  
Character of Well (Completed as Oil, Gas or Dry Hole)  
Dry Hole

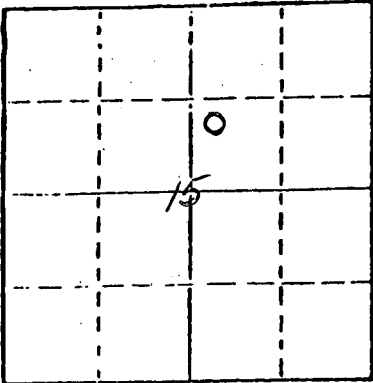

Locate well correctly on above  
Section Plot

Date Well completed Oct. 28, 1977  
Application for plugging filed(verbally) Oct. 28, 1977  
Application for plugging approved(verbally) Oct. 28, 1977  
Plugging commenced Oct. 28, 1977  
Plugging completed Oct. 28, 1977  
Reason for abandonment of well or producing formation  
No commercial quantity of oil or gas encountered  
If a producing well is abandoned, date of last production 19

Was permission obtained from the Conservation Division or  
its agents before plugging was commenced? Yes

Name of Conservation Agent who supervised plugging of this well Gilbert Balthazor  
Producing formation \_\_\_\_\_ Depth to top \_\_\_\_\_ Bottom \_\_\_\_\_ Total Depth of Well 4020  
Show depth and thickness of all water, oil and gas formations.

OIL, GAS OR WATER RECORDS

CASING RECORD

FORMATION	CONTENT	FROM	TO	SIZE	PUT IN	PULLED OUT

Describe in detail the manner in which the well was plugged, indicating where the mud fluid was placed and the method or methods used in introducing it into the hold. If cement or other plugs were used, state the character of same and depth placed, from \_\_\_\_\_ feet to \_\_\_\_\_ feet for each plug set.

1st plug set at 1400' with 70 sacks  
2nd plug set at 240' with 20 sacks  
3rd plug set at 40' with 10 sacks  
Cemented with 50/50 posmix, 6% gel.  
Plug was down at 9:30 p.m., October 28, 1977

RECEIVED  
STATE CORPORATION COMMISSION  
NOV 01 1977  
11-01-1977

(If additional description is necessary, use BACK of this sheet)

Name of Plugging Contractor Abercrombie Drilling, Inc.

STATE OF Kansas COUNTY OF Sedgwick, ss.  
Jack L. Partridge, Ass't. Secretary-Treasurer (employee of owner) or (owner or operator)  
of the above-described well, being first duly sworn on oath, says: That I have knowledge of  
the facts, statements, and matters herein contained and the log of the above-described well  
as filed and that the same are true and correct. So help me God.

(Signature) Jack L. Partridge  
801 Union Center, Wichita, Kansas 67202  
(Address)

SUBSCRIBED AND SWORN TO before me this 31st day of October, 1977  
My commission expires July 21, 1979  
Sandra Richman  
Sandra Richman Notary Public.



**KANSAS DRILLERS LOG**


S. 15 T. 10S R. 30 <sup>1</sup>/<sub>4</sub> W

API No. 15 - 179 - 20484-00-00  
 County Number

Loc. C NW SW NE

County Sheridan

640 Acres  
N

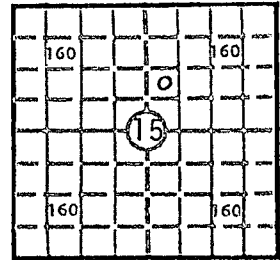

Elev.: Gr. 2895

DF 2898 KB 2900

Operator  
Abercrombie Drilling, Inc.

Address  
801 Union Center, Wichita, Kansas 67202

Well No. 1 Lease Name ALBERS

Footage Location  
feet from (N) (S) line \_\_\_\_\_ feet from (E) (W) line \_\_\_\_\_

Principal Contractor Abercrombie Drilling, Inc. Geologist Greg Cheney

Spud Date October 22, 1977 Total Depth 4020' P.B.T.D. \_\_\_\_\_

Date Completed October 28, 1977 Oil Purchaser \_\_\_\_\_

**CASING RECORD**

Report of all strings set— surface, intermediate, production, etc.

Purpose of string	Size hole drilled	Size casing set (in O.D.)	Weight lbs/ft.	Setting depth	Type cement	Sacks	Type and percent additives
Surface	12 1/4"	8-5/8"		237.28	Common	175	2% gel 3% CaCl

**LINER RECORD**

**PERFORATION RECORD**

Top, ft.	Bottom, ft.	Sacks cement	Shots per ft.	Size & type	Depth interval

Size	Setting depth	Packer set at

**ACID, FRACTURE, SHOT, CEMENT SQUEEZE RECORD**

Amount and kind of material used	Depth interval treated

**INITIAL PRODUCTION**

Date of first production \_\_\_\_\_ Producing method (flowing, pumping, gas lift, etc.) \_\_\_\_\_

RATE OF PRODUCTION PER 24 HOURS	Oil	Gas	Water	Gas-oil ratio
	bbls.	bbls.	MCF	CFPB

Disposition of gas (vented, used on lease or sold) \_\_\_\_\_ Producing interval (s) \_\_\_\_\_

INSTRUCTIONS: As provided in KCC Rule 82-2-125, within 90 days after completion of a well, one completed copy of this Drillers Log shall be transmitted to the State Geological Survey of Kansas, 4150 Monroe Street, Wichita, Kansas 67209. Copies of this form are available from the Conservation Division, State Corporation Commission, 3830 So. Meridian (P.O. Box 17027), Wichita, Kansas 66217. Phone AC 316-522-2206. If confidential custody is desired, please note Rule 82-2-125. Drillers Logs will be on open file in the Oil and Gas Division, State Geological Survey of Kansas, Lawrence, Kansas 66044.

15-179-20484-00-00

Operator **Abercrombie Drilling, Inc.** DESIGNATE TYPE OF COMP.: OIL, GAS, DRY HOLE, SWDW, ETC.: **Dry Hole**

Well No. **1** Lease Name **ALBERS**

S 15 T 10S R 30 <sup>EX</sup> <sub>W</sub>

**WELL LOG**

Show all important zones of porosity and contents thereof; cored intervals, and all drill-stem tests, including depth interval tested, cushion used, time tool open, flowing and shut-in pressures, and recoveries.

SHOW GEOLOGICAL MARKERS, LOGS RUN, OR OTHER DESCRIPTIVE INFORMATION.

FORMATION DESCRIPTION, CONTENTS, ETC.	TOP	BOTTOM	NAME	DEPTH
Sand & shale	0	1880		
Shale	1880	2140	SAMPLE TOPS:	
Shale & sand	2140	2462		
Anhydrite	2462	2498	Anhydrite	2462 (+438)
Shale	2498	2842	B/Anhydrite	2499 (+401)
Shale & lime	2842	3447	Heebner	3930 (-1030)
Lime & shale	3447	3755	Topeka	3710 (-810)
Shale & lime	3755	4020	Toronto	3959 (-1059)
Rotary Total Depth		4020	Lansing	3970 (-1070)

RECEIVED  
 COMMISSION  
 NOV 01 1977  
 11-01-1977  
 COMMISSION  
 Wichita, Kansas

USE ADDITIONAL SHEETS, IF NECESSARY, TO COMPLETE WELL RECORD.

Date Received	<p style="text-align: center;"><i>Jack L. Partridge</i> Signature</p> <p style="text-align: center;">Jack L. Partridge, Ass't. Secretary-Treasurer Title</p> <p style="text-align: center;">October 31, 1977 Date</p>
---------------	---