


STATE OF KANSAS  
STATE CORPORATION COMMISSION

Form CP-4

Give All Information Completely  
Make Required Affidavit  
Mail or Deliver Report to:  
Conservation Division  
State Corporation Commission  
212 No. Market  
Wichita, Kansas

WELL PLUGGING RECORD

NORTH

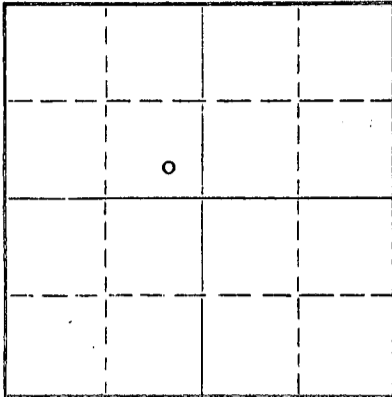

Locate well correctly on above  
Section Plat

Graham County, Sec. 35 Twp. 10S Rge. 25W (E) (W)  
Location as "NE/CNW/SW" or footage from lines SE SE NW  
Lease Owner Landes Exploration Co., & Franks Petroleum Co.  
Lease Name Knoll Well No. 1  
Office Address P. O. Box 867, Magnolia, Arkansas 71753  
Character of Well (completed as Oil, Gas or Dry Hole) Dry Hole  
Date well completed July 9 19 69  
Application for plugging filed July 9 19 69  
Application for plugging approved July 9 19 69  
Plugging commenced July 9 19 69  
Plugging completed July 9 19 69  
Reason for abandonment of well or producing formation Dry Hole

If a producing well is abandoned, date of last production 19  
Was permission obtained from the Conservation Division or its agents before plugging was commenced? Yes

Name of Conservation Agent who supervised plugging of this well W. L. Nichols, Moreland, Kansas  
Producing formation \_\_\_\_\_ Depth to top \_\_\_\_\_ Bottom \_\_\_\_\_ Total Depth of Well 3828 Feet  
Show depth and thickness of all water, oil and gas formations.

OIL, GAS OR WATER RECORDS

CASING RECORD

FORMATION	CONTENT	FROM	TO	SIZE	PUT IN	PULLED OUT
		0	216'	8 5/8"	216'	None
		0				

Describe in detail the manner in which the well was plugged, indicating where the mud fluid was placed and the method or methods used in introducing it into the hole. If cement or other plugs were used, state the character of same and depth placed, from \_\_\_\_\_ feet to \_\_\_\_\_ feet for each plug set.

Plug: 1175'/100 sacks cement  
240'/20 sacks cement  
40'/10 sacks cement @ bridge

RECEIVED  
STATE CORPORATION COMMISSION  
JUL 15 1969  
CONSERVATION DIVISION  
Wichita, Kansas


(If additional description is necessary, use BACK of this sheet)  
Name of Plugging Contractor Hellar Drilling Company, Inc.  
Address 339 Union Center Bldg., Wichita, Kansas 67202

STATE OF Kansas COUNTY OF Sedgwick, ss.  
D. L. Hellar, Pres. of Hellar Drilling Company, Inc. (employee of owner) or (owner or operator) of the above-described

well, being first duly sworn on oath, says: That I have knowledge of the facts, statements, and matters herein contained and the log of the above-described well as filed and that the same are true and correct. So help me God.

(Signature) D. L. Hellar D. L. Hellar, President  
339 Union Center Bldg., Wichita, Kansas 67202  
(Address)

Subscribed and sworn to before me this 14th day of July, 19 69  
Catherine Darcey  
Catherine Darcey Notary Public.  
My commission expires March 25, 1972

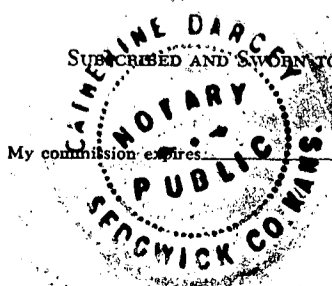

DRILLER'S LOG

COMPANY: Landes Exploration Co. and Franks Petroleum Co.,  
 P. O. Box 867, Magnolia, Arkansas 71753  
 CONTRACTOR: Hellar Drilling Co., Wichita, Kansas  
 LEASE: #1 Knoll  
 LOCATION: SE SE NW Sec. 35-10S-25W, Graham County, Kansas  
 COMMENCED: July 2, 1969  
 COMPLETED: July 9, 1969  
 CASING: Set 8 5/8" Surface Casing @ 216'/150 sacks cement

0-375	Shale
375-850	Shale & some chalk
850-1883	Shale
1883-2135	Shale & Red Bed
2135-2180	Anhydrite
2180-2715	Shale & Lime
2715-3828	Lime & Shale
3828	Rotary Total Depth

D & A

STATE OF KANSAS )  
 ) SS  
 COUNTY OF SEDGWICK )

I, D. L. Hellar, do hereby certify that the above and foregoing is a true and correct copy of the log of the #1 Knoll, located in SE SE NW 35-10S-25W, Graham County, Kansas, as reflected by the files of the Hellar Drilling Company, Inc.

HELLAR DRILLING COMPANY, INC.

By *D. L. Hellar*  
 President - D. L. Hellar

Subscribed and sworn to before me, a Notary Public, in and for Sedgwick County, Kansas, this 14th day of July, 1969.

*Catherine Darcey*  
 Notary Public - Catherine Darcey



My Commission Expires March 25, 1972.

