


STATE OF KANSAS
STATE CORPORATION COMMISSION

WELL PLUGGING RECORD

Give All Information Completely
Make Required Affidavit
Mail or Deliver Report to
Conservation Division
State Corporation Comm.
245 North Water
Wichita, KS 67202

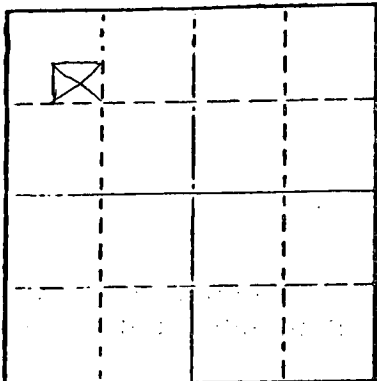

Locate well correctly on above
Section Plot

Sheridan County, Sec. 8 Twp. 10S Rge. 26 E/W
Location as "NE/CNW $\frac{1}{2}$ SW $\frac{1}{2}$ " or footage from lines
NW NW SE

Lease Owner The Maurice L. Brown Co.

Lease Name SAUER Well No. 1

Office Address 1500 Vickers KSB&T Bldg. Wichita, Ks. 67202

Character of Well (Completed as Oil, Gas or Dry Hole)
Dry Hole

Date Well completed August 17 1976

Application for plugging filed (verbally August 17) 1976

Application for plugging approved (verbally 8-17) 1976

Plugging commenced August 17 1976

Plugging completed August 17 1976

Reason for abandonment of well or producing formation
No commercial quantity of oil or gas encountered.

If a producing well is abandoned, date of last production
19

Was permission obtained from the Conservation Division or
its agents before plugging was commenced? Yes

Name of Conservation Agent who supervised plugging of this well
Producing formation Depth to top Bottom Total Depth of Well
Show depth and thickness of all water, oil and gas formations.

OIL, GAS OR WATER RECORDS

CASING RECORD

FORMATION	CONTENT	FROM	TO	SIZE	PUT IN	PULLED OUT
				8 5/8"	249' K B.	None

Describe in detail the manner in which the well was plugged, indicating where the mud fluid was placed and the method or methods used in introducing it into the hold. If cement or other plugs were used, state the character of same and depth placed, from feet to feet for each plug set.

1st Plug set at 1100' with 70 sx.
2nd Plug set at 250' with 20 sx.
40' bridge with 10 sx.

RECEIVED
STATE CORPORATION COMMISSION

Plug was down at 2:30 a.m. 8-17-76.
STATE PLUGGER: Gilbert Balthazor


AUG 23 1976
08-23-76
CONSERVATION DIVISION
Wichita, Kansas

(If additional description is necessary, use BACK of this sheet)

Name of Plugging Contractor

STATE OF Kansas COUNTY OF Sedgwick ss.
Jack K. Wharton - Geological Engineer (employee of owner) or (owner or operator) of the above-described well, being first duly sworn on oath, says: That I have knowledge of the facts, statements, and matters herein contained and the log of the above-described well as filed and that the same are true and correct. So help me God.

(Signature) Jack K. Wharton
801 Union Center, Wichita, Kansas 67202
(Address)

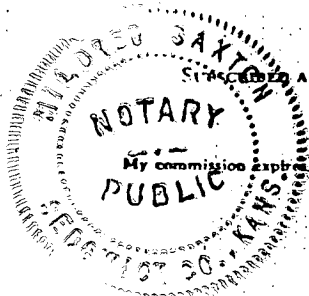

AND SWORN TO before me this 20th day of August 1976
October 5, 1976
Mildred Saxton
Notary Public.

CONTRACTOR'S WELL LOG

OPERATOR: The Maurice L. Brown Co.
 CONTRACTOR: Abercrombie Drilling, Inc.
 WELL NAME: SAUER #1 Sheridan County, Ks.
 LOCATION: NW NW SE Section 8-10S-26W
 SPUD DATE: August 7, 1976
 COMPLETION DATE: August 17, 1976
 Elevation: Gr: 2596
 KB: 2601

0	85	Surface Clay
85	155	Sand
155	1840	Shale
1840	2000	Sand
2000	2223	Shale
2223	2258	Anhydrite
2258	2727	Shale
2727	2985	Shale & Lime
2985	3135	Shale
3135	3660	Shale & Lime
3660	3732	Lime & Shale
3732	4110	Lime
	4110	Rotary Total Depth

Spud surface hole at 9:45 a.m. 8-07-76. Drilled 12 1/4" hole to 252'. Ran 6 jts 8 5/8" Tally 242', set at 249' K.B. with 190 sx. Class "A" cement, 3% Ca. Cl. Plug down at 2:50 p.m. 8-07-76.

T.D. 4110'. Plugged at 1100' with 70 sx. of cement, 50/50 posmix, 6% gel, 250' with 20 sx. 40' bridge with 10 sx. Plug down at 2:30 a.m. 8-17-76. State plugger Gilbert Balthazon, Palco, Kansas.

SAMPLE TOPS:

Anhydrite 2223' (+378)
 B/Anhydrite 2258' (+343)

STATE OF KANSAS)
) SS
 COUNTY OF SEDGWICK)

Jack K, Wharton, Geological Engineer for Abercrombie Drilling, Inc., does hereby state that the above and foregoing is a true and correct copy of the log of the SAUER #1, NW NW SE, Section 8-10S-26W, Sheridan County, Kansas.

ABERCROMBIE DRILLING, INC,

By: Jack K. Wharton
 Jack K, Wharton, Geological Engineer

Subscribed and sworn to before me, a Notary Public, in and for the aforesaid county and state as of this 20th day of August, 1976.

Mildred Saxton
 Mildred Saxton, Notary Public

