

15-179-20690-0000

JUL 19 1983


STATE OF KANSAS  
STATE CORPORATION COMMISSION  
200 Colorado Derby Bldg.  
Wichita, Kansas 67202

Form CP-4  
Rev. 12-15-80

WELL PLUGGING RECORD

Give All Information Completely  
Make Required Affidavit

COUNTY Sheridan SEC. 9 TWP. 10S RGE. 26W xE/W  
Location as in quarters or footage from lines:  
1070 FSL & 950 FWL

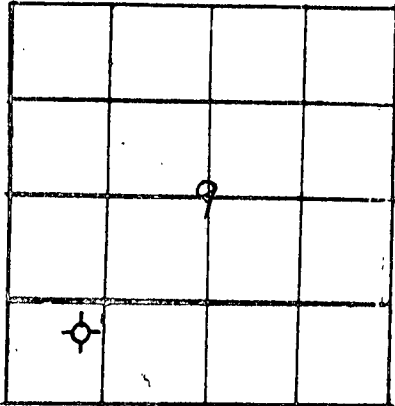

Locate Well  
correctly on above  
Section Platt.

Lease Owner Gear Petroleum Co., Inc.  
Lease Name Werth Well No. 1-9  
Office Address 300 Sutton Place, Wichita, Ks. 67202  
Character of Well (Completed as Oil, Gas or Dry Hole): D.H. (c)  
Date Well Completed 7-15-83  
Application for plugging filed 7-15-83  
Plugging commenced 7-15-83  
Plugging completed 7-15-83  
Reason for abandonment of well or producing formation \_\_\_\_\_

Was permission obtained from the Conservation Division or it's  
Agent's before plugging was commenced? yes

Name of Conservation Agent who supervised plugging of this well Carl Goodrow

Producing formation \_\_\_\_\_ Depth to top \_\_\_\_\_ bottom T.D. 4150'

Show depth and thickness of all water, oil and gas formations.

OIL, GAS OR WATER RECORDS

Casing Record

Formation	Content	From	To	Size	Put in	Pulled Out
Surface	7 jts. new	24# 8 5/8"	294'	set @	303'	0

Describe in detail the manner in which the well was plugged, indicating where the mud  
fluid was placed and the method or methods used in introducing it into the hold. If cement  
or other plugs were used, state the character of same and depth placed, from \_\_\_\_\_ feet  
to \_\_\_\_\_ feet for each plug set.

Plugged w/ 90 sx. 50-50 pos mix, 6% gel, 3% c.c.  
20 sx. @ 2250', 100 sx. @ 1300', 40 sx. @ 300',  
10 sx. @ 40', 10 sx. in Mouse hole, 10 sx. rat  
hole, T.D. 4150' State Plugger Carl Goodrow

STARTED at 5:00 PM Completed at 8:30 PM

(If additional description is necessary, use BACK of this sheet)

Name of Plugging Contractor Warrior Drilling Co., Rig #2

STATE OF Kansas COUNTY OF Sedgwick, ss.

F.W. SHELTON, JR., VICE PRES. (employee of owner) or (owner or operator) of the  
above-described well, being first duly sworn on oath, says: That I have knowledge of the  
facts, statements, and matters herein contained and the log of the above-described well as  
filed and that the same are true and correct. So help me God.


STATE CORPORATION COMMISSION

(Signature) F.W. Shelton Jr.

F.W. SHELTON, JR., VICE PRES.  
(Address)

JUL 22 1983

SUBSCRIBED AND SWORN TO before me this \_\_\_\_\_ day of \_\_\_\_\_ 1983

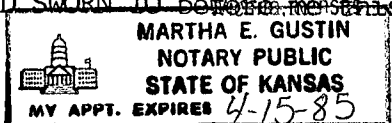

15<sup>th</sup> day of July, 19 83

Martha E. Gustin  
MARTHA E. GUSTIN Notary Public

My Commission expires \_\_\_\_\_