


STATE OF KANSAS
STATE CORPORATION COMMISSION

Give All Information Completely
Make Required Affidavit
Mail or Deliver Report to:
Conservation Division
State Corporation Commission
212 North Market, Insurance Bldg.
Wichita, Kansas

WELL PLUGGING RECORD

NORTH

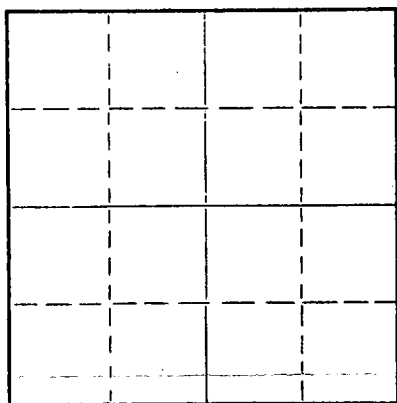

Locate well correctly on above
Section Plat

SHERIDAN County. Sec. 11 Twp. 10S Rge. 26W (E) (W)
Location as "NE/CNW%SW%" or footage from lines NW SE NW
Lease Owner HINKLE, FARMER & NADEL & GUSSMAN
Lease Name #1 Bittel Well No. _____
Office Address P.O. Box 352, Russell, Kansas
Character of Well (completed as Oil, Gas or Dry Hole) Dry Hole
Date well completed 7-18-72 19____
Application for plugging filed 7-18-72 19____
Application for plugging approved 7-18-72 19____
Plugging commenced 7-18-72 19____
Plugging completed 7-19-72 3:30A.M. 19____
Reason for abandonment of well or producing formation _____

If a producing well is abandoned, date of last production _____ 19____
Was permission obtained from the Conservation Division or its agents before plugging was commenced? yes

Name of Conservation Agent who supervised plugging of this well Leo Massey - Hays, Kansas
Producing formation _____ Depth to top _____ Bottom _____ Total Depth of Well _____ Feet
Show depth and thickness of all water, oil and gas formations.

OIL, GAS OR WATER RECORDS

CASING RECORD

FORMATION	CONTENT	FROM	TO	SIZE	PUT IN	PULLED OUT

Describe in detail the manner in which the well was plugged, indicating where the mud fluid was placed and the method or methods used in introducing it into the hole. If cement or other plugs were used, state the character of same and depth placed, from _____ feet to _____ feet for each plug set.

Plug #1 1200' 70 sx. cement
#2 210' 20 sx. cement
#3 40' 10 sx. cement

RECEIVED
STATE CORPORATION COMMISSION
JUL 24 1972
CONSERVATION DIVISION
Wichita, Kansas


(If additional description is necessary, use BACK of this sheet)
Name of Plugging Contractor John O. Farmer, Inc.
Address P.O. Box 352, Russell, Kansas 67665

STATE OF KANSAS, COUNTY OF RUSSELL, ss.

(employee of owner) or (owner or operator) of the above-described well, being first duly sworn on oath, says: That I have knowledge of the facts, statements, and matters herein contained and the log of the above-described well as filed and that the same are true and correct. So help me God.

(Signature) John O. Farmer
P.O. Box 352, Russell, Kansas 67665
(Address)

SUBSCRIBED AND SWORN TO before me this 21st. day of July, 1972

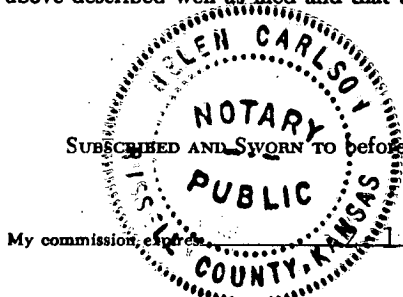

My commission expires 1-15-75 Helen Carlson Notary Public.


OPERATOR JOHN O. FARMER, INC.

FORMATION RECORD

ADDRESS Russell, Kansas 67665

Give detailed description and thickness of all formation drilled through, contents of sand, whether dry, water, oil or gas.

640 Acres
N

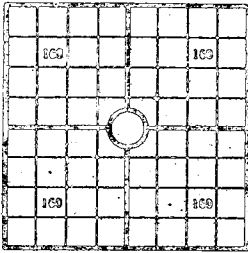

COUNTY Sheridan Sec. 11 TWP. 10s RGE. 26w
 COMPANY OPERATING John O. Farmer, Inc.
 OFFICE ADDRESS Box 352, Russell, Ks.
 DRILLING STARTED 7-13, 1972 DRILLING FINISHED 7-18-72
 DATE OF FIRST PRODUCTION _____ COMPLETED _____
 WELL LOCATED _____ $\frac{1}{4}$ _____ $\frac{1}{4}$ _____ $\frac{1}{4}$ _____, North of South
 Line and NW SE NW ft. East of West Line of Quarter Section
 Elevation (Relative to sea level) DERRICK FLOOR 2608 GROUND, 2603
 CHARACTER OF WELL (Oil, gas or dryhole) Dry Hole

OIL OR GAS SANDS OR ZONES

Name	From	To	Name	From	To
1			4		
2			5		
3			6		

Perforating Record If Any

Shot Record

Formation	From	To	No. of Shots	Formation	From	To	Size of Shot

CASING RECORD

Amount Set								Amount Pulled		Packer Record	
Size	Wt.	Thds.	Make	Ft.	In.	Ft.	In.	Size	Length	Depth Set	Make

Liner Record: Amount _____ Kind _____ Top _____ Bottom _____

CEMENTING AND MUDDING

Size	Amount Set		Sacks Cement	Chemical		Method of Cementing	Amount	Mudding Method	Results (See Note)
	Ft.	In.		Gal.	Make				
5/8	219		150						

Note: What method was used to protect sands if outer strings were pulled? _____

NOTE: Were bottom hole plugs used? _____ If so, state kind, depth set and results obtained _____

TOOLS USED

Rotary Tools were used from 0 feet to 3860 feet. _____ tools were used from _____ feet to _____ feet, and from _____ feet to _____ feet, and from _____ feet to _____ feet.

Type Rig Rotary

INITIAL PRODUCTION TEST


Describe initial test: whether by flow through tubing or casing or by pumping _____

Amount of Oil Production _____ bbls. Size of choke, if any _____ Length of test _____ Water

Production _____ bbls. Gravity of oil _____ Type of Pump if pump is used, describe _____

Formation	Top	Bottom	Formation	Top	Bottom
Anhydrite	2230				
Heebner	3837				
LOG TOPS					
Top Anhydrite	2233				
B/Anhydrite	2272				
Topeka	3622				
Heebner	3837				
Log T.D.	3858				
SAMPLE TOPS					
Shale	0	1550			
Shale & Sand	1550	1800			
Sand	1800	2005			
Red Bed	2005	2230			
Anhydrite	2230	2269			
Shale	2269	2290			
Shale & Shells	2290	2535			
Shale & Lime	2535	2895			
Lime & Shale	2895	3860			
R.T.D.	3860				

RECEIVED
 STATE CORPORATION COMMISSION
 JUL 24 1972
 CONSERVATION DIVISION
 Wichita, Kansas

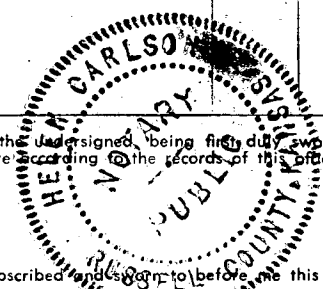

I, the undersigned, being first duly sworn upon oath, state that this well record is true, correct and complete according to the records of this office and to the best of my knowledge and belief.

John O. Farmer
 Name and title of representative of company
 President

Subscribed and sworn to before me this 21st day of July, 1972

My Commission expires 7-15-75

Helen Carlson
 Notary Public.

Helen Carlson

NAME BITTEL
 WELL NO. L
 COUNTY SHERIDAN
 SEC. 11
 TWP. 10S
 RGE. 26W
 15-174-20317-0000