

15-065-21827-0000


STATE OF KANSAS
STATE CORPORATION COMMISSION
200 Colorado Derby Bldg.
Wichita, Kansas 67202

Form CP-4
Rev. 12-15-80

WELL PLUGGING RECORD

Give All Information Completely
Make Required Affidavit

COUNTY Graham SEC. 17 TWP. 9S RGE. 23W ~~XX~~/W
Location as in quarters or footage from lines:
SE NW NW

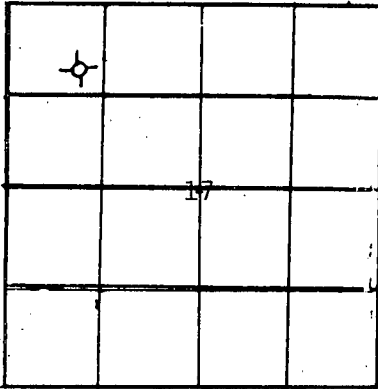

Locate Well
correctly on above
Section Platt.

Lease Owner KATO Operating Company
Lease Name Evergreen Lansing Kansas City Unit Well No. #20
Office Address P.O. Box 960, Bristow, OK 74010
Character of Well (Completed as Oil, Gas or Dry Hole): Dry Hole
Date Well Completed July 26, 1983
Application for plugging filed Attached
Plugging commenced _____
Plugging completed 7:30 P.M., July 26, 1983
Reason for abandonment of well or producing formation _____

Dry
Was permission obtained from the Conservation Division or it's
Agent's before plugging was commenced? Yes

Name of Conservation Agent who supervised plugging of this well _____
Producing formation _____ Depth to top _____ bottom _____ T.D. 3900'
Show depth and thickness of all water, oil and gas formations.

OIL, GAS OR WATER RECORDS

Casing Record

Formation	Content	From	To	Size	Put in	Pulled Out
				281'	8-5/8"	

Describe in detail the manner in which the well was plugged, indicating where the mud fluid was placed and the method or methods used in introducing it into the hold. If cement or other plugs were used, state the character of same and depth placed, from _____ feet to _____ feet for each plug set.

- Plug #1 @ 1979' w/20 sks. cement
 - Plug #2 @ 1152' w/100 sks. cement
 - Plug #3 @ 330' w/40 sks. cement
 - Plug #4 @ 40' w/10 sks. cement
- 10 sks. cement in rathole

(If additional description is necessary, use BACK of this sheet)


Name of Plugging Contractor John O. Farmer, Inc.
P.O. Box 352, Russell, KS 67665

STATE OF Oklahoma COUNTY OF Creek, ss.
B. E. Livingston (employee of owner) or (owner or operator) of the
above-described well, being first duly sworn on oath, says: That I have knowledge of the
facts, statements, and matters herein contained and the log of the above-described well as
filed and that the same are true and correct so help me God.

RECEIVED
STATE CORPORATION COMMISSION
8-10-83
AUG 10 1983

(Signature) [Handwritten Signature]
P.O. Box 960 (Address) Bristow, OK 74010

SUBSCRIBED AND SWORN TO before me this 8 day of August, 1983
Lawrence J. Keeley
Notary Public

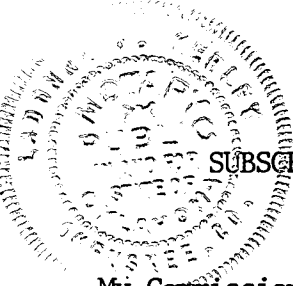

My Commission expires: 7-14-87