


15-065-00207-0000

STATE OF KANSAS
STATE CORPORATION COMMISSION

WELL PLUGGING RECORD

Give All Information Completely
Make Required Affidavit
Mail or Deliver Report to:
Conservation Division
State Corporation Commission
800 Bitting Building
Wichita, Kansas

NORTH

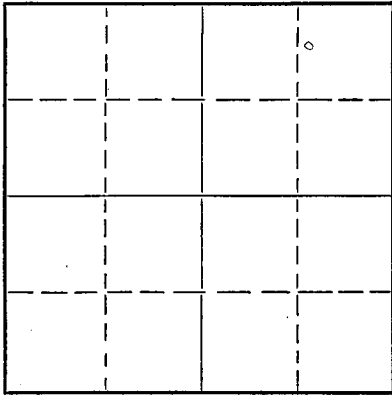

Locate well correctly on above
Section Plat

Graham County, Sec. 17, Twp. 9S, Rge. 23 (W)
Location as "NE/CNW 1/4 SW 1/4" or footage from lines NE NE NE
Lease Owner The Palmer Oil Corporation
Lease Name Robinson Well No. 1
Office Address 415 Union National Bank Bldg., Wichita 2, Kansas
Character of Well (completed as Oil, Gas or Dry Hole) Dry Hole
Date well completed 4/24/52 19
Application for plugging filed 4/24/52 19
Application for plugging approved 4/24/52 19
Plugging commenced 4/24/52 19
Plugging completed 4/24/52 19
Reason for abandonment of well or producing formation

If a producing well is abandoned, date of last production 19
Was permission obtained from the Conservation Division or its agents before plugging was commenced? Yes

Name of Conservation Agent who supervised plugging of this well Eldon Petty
Producing formation Depth to top Bottom Total Depth of Well 4300 Feet
Show depth and thickness of all water, oil and gas formations.

OIL, GAS OR WATER RECORDS

CASING RECORD

Formation	Content	From	To	Size	Put In	Pulled Out
				8 5/8"	146	None

Describe in detail the manner in which the well was plugged, indicating where the mud fluid was placed and the method or methods used in introducing it into the hole. If cement or other plugs were used, state the character of same and depth placed, from feet to feet for each plug set.

Filled hole with heavy mud from 4300' to 140' - plug and 15 sacks cement, heavy mud to 40' - plug and 10 sacks cement.

(If additional description is necessary, use BACK of this sheet)

Name of Plugging Contractor The Palmer Oil Corporation
Address 415 Union National Bank Building
Wichita 2, Kansas

STATE OF Kansas, COUNTY OF Sedgwick, ss.
A. H. Smith (employee of owner) or (owner or operator) of the above-described well,

being first duly sworn on oath, says: That I have knowledge of the facts, statements, and matters herein contained and the log of the above-described well as filed and that the same are true and correct. So help me God.

(Signature) A. H. Smith


(Address)

SUBSCRIBED AND SWORN TO before me this 1st day of May, 19 52.

My commission expires 9/30/52

Olaf M. Kolling Notary Public.

23-8390-s 6-51-20M

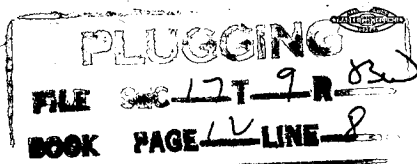

Received 5-1-52 KCC

WELL LOG - ROBINSON #1

WELL OWNER: The Palmer Oil Corporation

Location: NE NE NE

CONTRACTOR: The Palmer Oil Corporation

Section 17-9S-23W

Graham County, Kansas

Elevation: 2412 R. B.

Commenced: 4/11/52

Completed: 4/24/52

RESULTS: Dry Hole

Shale & sand	0	146
Blue shale	146	326
Shale & shells	326	1170
Sand	1170	1350
Shale & red bed	1350	1459
Red bed	1459	2050
Anhydrite	2050	2086
Shale & shells	2086	2708
Lime	2708	2847
Shale & shells	2847	2965
Lime & shale	2965	3065
Shale & lime	3065	3185
Lime & shale	3185	3655
Lime	3655	3978
Lime & shale	3978	3992
Lime	3992	4170
Lime & shale	4170	4202
Lime	4202	4225
Cherty Conglomerate	4225	4233
Conglomerate	4233	4280
Arbuckle lime?	4280	4300 Total Depth

Casing Record

8 5/8" - 146' cemented 100 sacks

Formation Tops (R. B.)

Heebner	3708
Lansing	3747
Base Kansas C.	3960
Conglomerate	4216
Arbuckle	4274

This is to certify that the above is a true and correct log, according to the daily drilling reports.

THE PALMER OIL CORPORATION

By A. H. Smith

STATE OF KANSAS)
SEDGWICK COUNTY) ss:

Subscribed and sworn to before me, a Notary Public, in and for said County and State, this 1st day of May, 1952.

Olof M. Kollings
Notary Public

My Commission Expires: 9/30/53

PLUGGING
FILE NO. 17-T-9-R-230
BOOK PAGE 14 LINE 1