


15-065-30354-00-00

WELL PLUGGING RECORD

Give All Information Completely
Make Required Affidavit
Mail or Deliver Report to:
Conservation Division
State Corporation Commission
212 North Market, Insurance Bldg.
Wichita, Kansas

Graham County, Sec. 23 Twp. 9 Rge. 23 (E) W (W)

NORTH

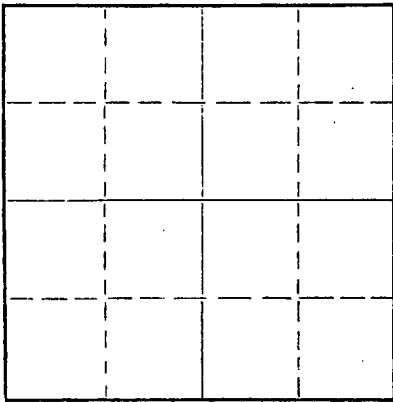

Locate well correctly on above
Section Plat

Location as "NE/CNW/SW" or footage from lines SE SE NW
Lease Owner Burch Drilling Company, Inc.
Lease Name Goddard Well No. 1
Office Address Wichita, Kansas
Character of Well (completed as Oil, Gas or Dry Hole) _____
Date well completed _____ 19____
Application for plugging filed _____ 19____
Application for plugging approved _____ 19____
Plugging commenced 8-4-60 _____ 19____
Plugging completed 8-5-60 _____ 19____
Reason for abandonment of well or producing formation Depleted.

If a producing well is abandoned, date of last production _____ 19____
Was permission obtained from the Conservation Division or its agents before plugging was commenced? YES

Name of Conservation Agent who supervised plugging of this well A. D. Fabricius.
Producing formation _____ Depth to top _____ Bottom _____ Total Depth of Well 3920 Feet
Show depth and thickness of all water, oil and gas formations.

OIL, GAS OR WATER RECORDS

CASING RECORD

FORMATION	CONTENT	FROM	TO	SIZE	PUT IN	PULLED OUT
				8-5/8"	210'	None
				5-1/2"	3920'	1315'

Describe in detail the manner in which the well was plugged, indicating where the mud fluid was placed and the method or methods used in introducing it into the hole. If cement or other plugs were used, state the character of same and depth placed, from _____ feet to _____ feet for each plug set.

Checked hole to 3885' and found it clear.
Ran 130 gal. of sand to 3760'. Pulled 5' casing. Checked fluid to 200', set 10' rock bridge to 190' and ran 25 sacks of cement. Mudded hole to 40', set rock bridge to 30' and ran 10 sacks of cement to base of cellar.

PLUGGING COMPLETED.

RECEIVED
STATE CORPORATION COMMISSION
AUG 19 1960
CONSERVATION DIVISION
Wichita, Kansas

Name of Plugging Contractor Knight Casing Pulling Co. 8-19-60
Address Chase, Kansas

STATE OF Kansas, COUNTY OF Rice, ss.
Noel J. Knight (employee of owner) or (owner or operator) of the above-described well, being first duly sworn on oath, says: That I have knowledge of the facts, statements, and matters herein contained and the log of the above-described well as filed and that the same are true and correct. So help me God.

(Signature) Noel J. Knight
Chase, Kansas
(Address)

SUBSCRIBED AND SWORN TO before me this 11th day of August, 1960

My commission expires May 20, 1964 Milton J. Volin Notary Public.



13-065-30354-00-00

WELL LOG

Burch Drilling Co., Inc.
411 Goddard
SE 1/4 NW, Sec. 23-95-13W
Graham County, Kansas

Set 212' 3 5/8" with 175 sacks
Commenced: 7-6-59
Completed: 7-14-59
ELEVATION: 2378 KB
Set 3939' 5 1/2" with 125 Sacks

210 Cement
1920 Shale & Shells
1987 Shale
2020 Anhydrite
2100 Shale
2505 Shale & Lime Streaks
3500 Lime & Shale
3940 Lime
3940 Rotary Total Depth

TOPS
HEEBNER 3663 (-1285)
TORONTO 3687 (-1306)
LANSING 3699 (-1321)
BASE KANSAS CITY 3919 (-1541)

DST # 1 3761-3790. Open 1 hour.
Recovered 240' gas, 85' Oil and
gas cut mud, 120' heavily oil and
gas cut mud, 120' very muddy oil.
IBHP (30 min) 12550, IFF 400,
FFP 1070, FBHP (30 min) 11410.

DST # 2 Open 30 minutes. 3845-3880.
Recovered 10' Mud. IBHP (30 min)
650. IFF & FFP 00. FBHP 00.

VED
COMMISSION
AUG 30 1960
CONSERVATION DIVISION
Wichita, Kansas

8-30-60

STATE OF KANSAS, COUNTY OF SEDGWICK:

I, Earl M. Burch, President of Burch Drilling Co., Inc. being duly sworn on
oath, state: That I have knowledge of the facts, statements and matters herein contained,
and that the same are true and correct.

Earl M. Burch
Earl M. Burch

Subscribed and sworn to before me this 17th day of July, 1959/

Shirley Ann Ann
Notary Public

My commission expires: March 12, 1963.