

15-179-00088-00-00


WELL PLUGGING RECORD

Give All Information Completely  
Make Required Affidavit  
Mail or Deliver Report to:  
Conservation Division  
State Corporation Commission  
212 North Market, Insurance Bldg.  
Wichita, Kansas

Sheridan County, Sec. 25 Twp. 10S Rge. 27W (X) (W)

Location as "NE/CNW/SW" or footage from lines SW SE NE  
Lease Owner BELL OIL AND GAS COMPANY  
Lease Name YOUNGER Well No. 1  
Office Address P.O. Box 2007, Tulsa, Oklahoma  
Character of Well (completed as Oil, Gas or Dry Hole) Dry Hole  
Date well completed March 26 1961  
Application for plugging filed March 26 1961  
Application for plugging approved March 26 1961  
Plugging commenced March 26 1961  
Plugging completed March 26 1961  
Reason for abandonment of well or producing formation Dry hole

NORTH

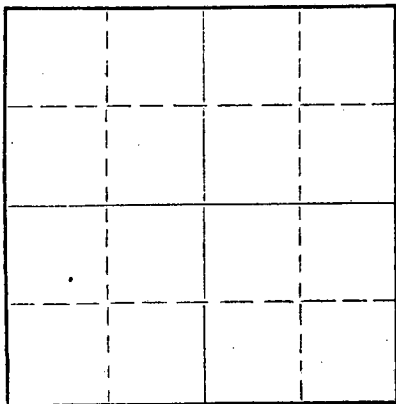

Locate well correctly on above  
Section Plat.

If a producing well is abandoned, date of last production \_\_\_\_\_ 19\_\_\_\_  
Was permission obtained from the Conservation Division or its agents before plugging was commenced? Yes

Name of Conservation Agent who supervised plugging of this well A. D. Fabricius  
Producing formation \_\_\_\_\_ Depth to top \_\_\_\_\_ Bottom \_\_\_\_\_ Total Depth of Well 4045 Feet  
Show depth and thickness of all water, oil and gas formations.

OIL, GAS OR WATER RECORDS

CASING RECORD

FORMATION	CONTENT	FROM	TO	SIZE	PUT IN	PULLED OUT
				8 5/8"	234'	

Describe in detail the manner in which the well was plugged, indicating where the mud fluid was placed and the method or methods used in introducing it into the hole. If cement or other plugs were used, state the character of same and depth placed, from \_\_\_\_\_ feet to \_\_\_\_\_ feet for each plug set.

#1 Halliburton Plug set @ 500' w/ 1/2 sack hulls cemented through drill pipe with 20 sacks cement.  
#2 Halliburton Plug set @ 220' w/ 1/2 sack hulls cemented w/20 sacks through drill pipe.  
#3 Halliburton Plug set @ 40' w/ 1/2 sack hulls cemented w/10 sacks cement through cc bbl.

RECEIVED  
STATE CORPORATION COMMISSION

APR 3 1961

CONSERVATION DIVISION  
Wichita, Kansas

04-03-1961

(If additional description is necessary, use BACK of this sheet)

Name of Plugging Contractor K & E DRILLING, INC.  
Address 719 Union Center Bldg., Wichita, Kansas

STATE OF KANSAS, COUNTY OF SEDGWICK, ss.  
Dale Silcott (employee of owner) or (~~owner or operator~~) of the above-described well, being first duly sworn on oath, says: That I have knowledge of the facts, statements, and matters herein contained and the log of the above-described well as filed and that the same are true and correct. So help me God.

(Signature) Dale Silcott  
719 Union Center, Wichita, Kansas  
(Address)

SUBSCRIBED AND SWORN to before me this 29th day of March, 1961

Wildalee Wind  
Wildalee Wind - Notary Public.

My commission expires October 30, 1961



15-179-00088-00-00

# DRILLER'S WELL LOG

OPERATOR: BELL OIL AND GAS COMPANY  
P.O. Box 2007  
Tulsa, Oklahoma

WELL NAME: #1 YOUNGER  
LOCATION: SW SE NE Sec. 25-10S-27W  
Sheridan County, Kansas

CONTRACTOR: **K & E DRILLING, INC.**  
719 UNION CENTER BLDG.  
WICHITA, KANSAS

LOGGING RECORD: 8 5/8" @ 234' w/200 sx

COMMENCED: March 18, 1961

COMPLETED: March 26, 1961

ELEVATION: 2547' KB

ROTARY TOTAL DEPTH: 4045'

PRODUCTION: Dry Hole

## FORMATION RECORD

Depths shown indicate bottom of formations encountered.

Sand	50
Blue shale	225
Shale	1065
Shale and shells	1750
Sand	1920
Shale and red bed	2160
Anhydrite	2197
Shale and shells	2320
Shale and lime	2750
Lime	3010
Lime and shale	3160
Lime	3270
Shale	3400
Lime	3630
Lime and shale	3730
Lime	3978
Shale and lime	4045 RTD

**RECEIVED**  
STATE CONSERVATION COMMISSION

MAR 28 1961

CONSERVATION DIVISION  
Wichita, Kansas

04-03-1961

## CERTIFICATION

State of KANSAS }  
County of SEDGWICK } ss:

I, Dale Silcott, of K & E DRILLING, INC., upon oath state that the above and foregoing is a true and correct copy of the Driller's Log of the above named well.

Dale Silcott  
Dale Silcott

Subscribed and sworn to before me this 29th day of March, 1961.

Wildalee Wind  
Wildalee Wind - Notary Public.

My Commission expires: October 30, 1961

