


WELL PLUGGING RECORD

Give All Information Completely  
Make Required Affidavit  
Mail or Deliver Report to:  
Conservation Division  
State Corporation Commission  
800 Bitting Building  
Wichita, Kansas

NORTH

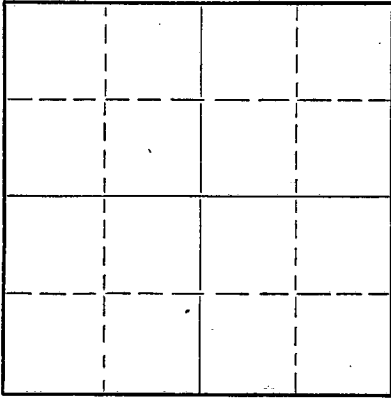

Locate well correctly on above  
Section Plat

Sheridan County. Sec. 15 Twp. 10 Rge. 28 (E) W (W)  
Location as "NE/CNW $\frac{1}{4}$ SW $\frac{1}{4}$ " or footage from lines NW/4 NW/4 NE/4  
Lease Owner M. B. Armer  
Lease Name Beicker Well No. 1  
Office Address Petroleum Building, Wichita, Kansas  
Character of Well (completed as Oil, Gas or Dry Hole) Dry Hole  
Date well completed 12-30-51  
Application for plugging filed 12-30-51  
Application for plugging approved 12-30-51  
Plugging commenced 12-30-51  
Plugging completed 12-30-51  
Reason for abandonment of well or producing formation

If a producing well is abandoned, date of last production 19\_\_\_\_  
Was permission obtained from the Conservation Division or its agents before plugging was commenced? Yes

Name of Conservation Agent who supervised plugging of this well Eldon Petty  
Producing formation \_\_\_\_\_ Depth to top \_\_\_\_\_ Bottom \_\_\_\_\_ Total Depth of Well 4691 Feet  
Show depth and thickness of all water, oil and gas formations.

OIL, GAS OR WATER RECORDS

CASING RECORD

Formation	Content	From	To	Size	Put In	Pulled Out
				8-5/8	160'	None

Describe in detail the manner in which the well was plugged, indicating where the mud fluid was placed and the method or methods used in introducing it into the hole. If cement or other plugs were used, state the character of same and depth placed, from \_\_\_\_\_ feet to \_\_\_\_\_ feet for each plug set.

Filled hole with heavy drilling mud to 140' set plug and cemented with 15 sacks cement. Filled hole to 40' set plug and cemented to bottom of cellar with 10 sacks cement.

STATE OF KANSAS  
JAN - 0 1952  
CONSERVATION DIVISION  
WICHITA, KANSAS  
01-09-1952

(If additional description is necessary, use BACK of this sheet)  
Name of Plugging Contractor Prime Drilling Company  
Address 1516 Apco Tower, Oklahoma

STATE OF Kansas, COUNTY OF Sedgwick, ss.  
G. W. Speer (employee of owner) of the above-described well,  
being first duly sworn on oath, says: That I have knowledge of the facts, statements, and matters herein contained and the log of the above-described well as filed and that the same are true and correct. So help me God.

(Signature) *Gus Speer*  
(Address)

SUBSCRIBED AND SWORN to before me this 8th day of January, 1952  
*Hazel Walter*  
Notary Public.

My commission expires September 17, 1955

23-8390-3 6-51-20M  
PLUGGING  
FILE SEC 15 T 10 R 24  
BOOK PAGE 135 LINE 3

15-179-00018-00-00

M. B. ARMER

BEICKER # 1

NW/4 NW/4 NE/4 Sec. 12-10S-28W

Sheridan County, Kansas

<u>FORMATION</u>	<u>FROM</u>	<u>TO</u>	<u>REMARKS</u>
Surface Clay & Sand	0	105	
Shale	105	160	
Shale & Shells	160	680	8-5/8" C.S.A. @ 160' Cemented with 100 Sacks Cement.
Chalk & Shale	680	850	
Shale	850	1055	
Shale & Shells	1055	1200	
Sand & Shale	1200	1445	
Shale & Shell	1445	1650	
Shale & Lime	1650	1735	
Shale Shells Red Bed	1735	1815	
Anhydrite	1815	1855	
Shale Shells Red Bed	1855	2150	
Red Bed Shale Shells	2150	2270	
Anhydrite	2270	2310	
Shale Shells Red Bed	2310	2605	
Shale & Lime	2605	2720	
Shale Red Bed & Lime	2720	2845	
Shale & Lime	2845	3200	
Lime & Shale	3200	3415	
Shale & Lime	3415	3705	
Lime & Shale	3705	3906	
Lime	3906	4110	
Lime & Shale	4110	4440	
Lime Shale Chert	4440	4450	
Cherty Lime	4450	4495	
Chert & Shale	4495	4510	
Cherty Lime	4510	4535	
Lime Shale Chert	4535	4680	
Lime	4680	4691	

Total Depth 4691'

I hereby certify the foregoing to be a true and accurate Driller's Log of the formations encountered in the above well.

PRIME DRILLING COMPANY

By: [Signature]  
I. J. Kruse, Secretary

Subscribed and sworn to before me this 4th day of January, 1952.

[Signature]  
Notary Public

My Commission Expires: October 24, 1955

PLUGGING  
FILE SEC-15110 R280  
BOOK PAGE 135 LINE 2