


15-179-00164-00-00

WELL PLUGGING RECORD

Give All Information Completely
Make Required Affidavit
Mail or Deliver Report to:
Conservation Division
State Corporation Commission
800 Biting Building
Wichita, Kansas

Sheridan County, Sec. 16 Twp. 10S Rge. 28 (E) (W)

Location as "NE/CNW/SW" or footage from lines NW/4 NW/4 NW/4
Lease Owner Heathman-Seeligson Drilling Co.
Lease Name Hein #1 Well No. 1
Office Address 1015 East Second, Wichita 7, Kansas
Character of Well (completed as Oil, Gas or Dry Hole) Dry Hole
Date well completed 7 8-15 19 56
Application for plugging filed 7 8-15 19 56
Application for plugging approved 7 8-15 19 56
Plugging commenced 7 8-15 19 56
Plugging completed 7 8-15 19 56
Reason for abandonment of well or producing formation Dry and abandoned

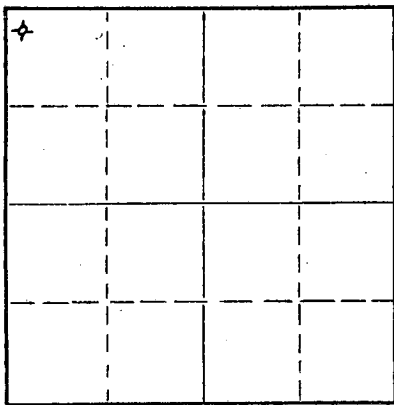

Locate well correctly on above Section Plat

If a producing well is abandoned, date of last production _____ 19____
Was permission obtained from the Conservation Division or its agents before plugging was commenced? Yes

Name of Conservation Agent who supervised plugging of this well Eldon Petty, Box 326, Hays, Kansas
Producing formation _____ Depth to top _____ Bottom _____ Total Depth of Well 4379 Feet
Show depth and thickness of all water, oil and gas formations.

OIL, GAS OR WATER RECORDS

CASING RECORD

FORMATION	CONTENT	FROM	TO	SIZE	PUT IN	PULLED OUT
				Ran 10 jts. 8 5/8"		
				used surface casing.		
				Cemented w/150 sacks		
				cement, 2 c.c. Cement		
				circulated.		

Describe in detail the manner in which the well was plugged, indicating where the mud fluid was placed and the method or methods used in introducing it into the hole. If cement or other plugs were used, state the character of same and depth placed, from _____ feet to _____ feet for each plug set.

Plugged hole at 195'. Filled hole w/heavy mud to 195' w/1/2 sack hulls and 15 sacks cement. Filled hole to 40' and set top plug w/1/2 sack hulls and 10 sacks cement.

(If additional description is necessary, use BACK of this sheet)

Name of Plugging Contractor Heathman-Seeligson Drilling Co.
Address 1015 East Second, Wichita, Kansas

STATE OF Kansas, COUNTY OF Sedgwick, ss.
H. E. Turner (employee of owner) or (~~owner~~) of the above-described well, being first duly sworn on oath, says: That I have knowledge of the facts, statements, and matters herein contained and the log of the above-described well as filed and that the same are true and correct. So help me God.

(Signature) H. E. Turner
1015 East Second, Wichita, Kansas
(Address)

SUBSCRIBED AND SWORN to before me this 18 day of July, 19 56

My commission expires April 3, 1960

Notary Public.

PLUGGING
FILE SEC. 16 T. 10 R. 28
BOOK PAGE 80 LINE 17

RECEIVED
STATE CORPORATION COMMISSION
JUL 24 1956
07-24-1956
CONSERVATION DIVISION
Wichita, Kansas

15-179-00164-00-00

DRILLERS' LOG

NAME: HEIN #1 DATE SPUDDED: 7-3-56
 LOCATION: NW/4 NW/4 NW/4 Sec. 16-10S-28W ROTARY COMPLETED: 7-15-56
 Sheridan County, Kansas
 OPERATOR: Heathman-Seeligson Drilling Co. ELEVATION: 2735 GR
 2738 NF
 2741 KB
 CONTRACTOR: Heathman-Seeligson Drilling Co. ROTARY TOTAL DEPTH: 4379'
 SURFACE CASING: Ran 10 jts. 8 5/8" used surface casing. Cemented w/150 sacks cement, 2 cc. Cement circulated.
 OIL STRING: None run - Dry and abandoned 7-15-56

GEOLOGICAL TOPS (KB)

Anhydrite	2300 (+ 441)
Heebner	3830 (-1089)
Toronto	3851 (-1110)
Lansing	3862 (-1121)
Base Kansas City	4114 (-1373)
Marmaton	4193 (-1452)
Cherokee	4318 (-1577)
R.T.D.	4379

LOG

(Figures indicate bottom of formation)

Shale and sand	0 - 70
Sand	110
Shale and shells	1200
Shale and sand	1350
Shale and shells	1650
Sand	1700
Shale	1810
Shale and shells	2018
Sandy shale	2140
Shale and shells	2240
Shale and red beds	2300
Anhydrite	2340
Shale and shells	2385
Shale and red bed	2545
Shale and shells	2710
Shale and lime	2905
Shale and shells	3095
Shale and lime	3255
Lime	3390
Sandy lime	3495
Lime	3746
Shale and lime	3815
Lime	4122
Lime and shale	4282
Shale and lime	4379

The undersigned, H. E. Turner, hereby certifies that the above log is a true and correct log of the formations encountered in drilling the above noted well as reflected by the Daily Drilling Report.

HEATHMAN-SEELIGSON DRILLING CO.

By: *H. E. Turner*

Subscribed and sworn to before me the 18th day of July, 1956.

Notary Public

PLUGGING
 FILE SEC 16 T.10 R28W
 BOOK PAGE 80 LINE 17

07-24-1956

My commission expires: April 3, 1960