


WELL PLUGGING RECORD

Give All Information Completely
Make Required Affidavit
Mail or Deliver Report to:
Conservation Division
State Corporation Commission
211 No. Broadway
Wichita, Kansas

NORTH

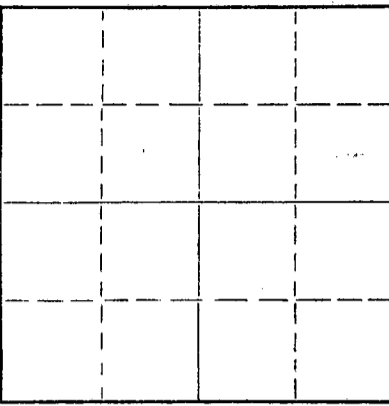

SHERIDAN County. Sec. 13 Twp. 10 Rge. (E) 29 (W)
Location as "NE/CNW/SW" or footage from lines CENTER NW SW
Lease Owner EMPIRE DRILLING COMPANY
Lease Name JOHNSON Well No. 1
Office Address 400 BROWN BUILDING WICHITA, KANSAS
Character of Well (completed as Oil, Gas or Dry Hole) DRY HOLE
Date well completed JUNE 26, 1957 19
Application for plugging filed JUNE 26, 1957 19
Application for plugging approved JUNE 26, 1957 19
Plugging commenced JUNE 26, 1957 19
Plugging completed JUNE 26, 1957 19
Reason for abandonment of well or producing formation DRY HOLE

If a producing well is abandoned, date of last production 19
Was permission obtained from the Conservation Division or its agents before plugging was commenced? YES

Name of Conservation Agent who supervised plugging of this well ELDON PETTY
Producing formation _____ Depth to top _____ Bottom _____ Total Depth of Well 4565 Feet
Show depth and thickness of all water, oil and gas formations.

OIL, GAS OR WATER RECORDS

CASING RECORD

FORMATION	CONTENT	FROM	TO	SIZE	PUT IN	PULLED OUT
SURFACE		0	210'	8 5/8"	210	0

Describe in detail the manner in which the well was plugged, indicating where the mud fluid was placed and the method or methods used in introducing it into the hole. If cement or other plugs were used, state the character of same and depth placed, from _____ feet to _____ feet for each plug set.

SET BOTTOM PLUG 205' 1/2 SACK HULLS 20 SACKS CEMENT
SET SECOND PLUG 40' 1/2 SACK HULLS 10 SACKS CEMENT TO TOP


07-08-1957
CONSERVATION DIVISION
Wichita, Kansas

(If additional description is necessary, use BACK of this sheet)
Name of Plugging Contractor EMPIRE DRILLING COMPANY
Address 400 BROWN BUILDING WICHITA, KANSAS

STATE OF KANSAS, COUNTY OF SEDGWICK, ss.
I, DAN J. KORNFELD, ~~employee of owner~~ (owner or operator) of the above-described well, being first duly sworn on oath, says: That I have knowledge of the facts, statements, and matters herein contained and the log of the above-described well as filed and that the same are true and correct. So help me God.

(Signature) [Signature]
400 BROWN BUILDING WICHITA, KANSAS
(Address)

SUBSCRIBED AND SWORN TO before me this 1st day of JULY, 1957.
My commission expires JULY 2, 1957
Hazel Pierson
HAZEL PIERSON Notary Public.

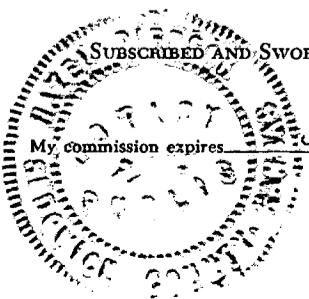

PLUGGING
SEC. 13 T. 10 R. 29 W
BOOK PAGE 24 LINE 1

LOG

COMPANY: EMPIRE DRILLING COMPANY, WICHITA, KANSAS

CONTRACTOR: EMPIRE DRILLING COMPANY, WICHITA, KANSAS

FARM: JOHNSON

LOCATION: CENTER NW SW SECTION 13-10-29 SHERIDAN COUNTY, KANSAS

COMPLETED: JUNE 12, 1957

ELEVATION: 2812 KB

COMPLETED: JUNE 26, 1957

0	TO	1420	SHALE AND SAND
1420	TO	1760	SHALE
1760	TO	2250	SHALE AND SHELLS
2250	TO	2410	SHALE
2410	TO	2445	ANHYDRITE
2445	TO	2685	SHALE
2685	TO	2925	SHALE AND SHELLS
2925	TO	3090	SHALE AND LIME
3090	TO	3215	SHALE
3215	TO	3600	LIME AND SHALE
3600	TO	3720	SHALE AND LIME
3720	TO	3900	LIME AND SHALE
3900	TO	4200	LIME
4200	TO	4290	SHALE AND LIME
4290	TO	4386	SHALE
4386	TO	4526	SHALE AND LIME
4526	TO	4565	CHERT LIME (MISS)
		4565	RTC D&A

RAN: 8 5/8" 210' SET WITH 125 SACKS CEMENT

TOPS:	ANHYDRITE	2410
	HEEBNER	3913
	TORONTO	3936
	LANSING KANSAS CITY	3952
	BASE KANSAS CITY	4206
	CHEROKEE	4404
	MISSISSIPPIAN	4508

I, DAN J. KORNFELD, DO HEREBY CERTIFY THAT THE ABOVE AND FOREGOING IS A TRUE AND CORRECT COPY OF THE LOG ON THE JOHNSON NUMBER 1 CENTER NW SW SECTION 13-10-29, SHERIDAN COUNTY, KANSAS AS REFLECTED BY THE FILES OF THE EMPIRE DRILLING COMPANY.

Dan J. Kornfeld
DAN J. KORNFELD

SUBSCRIBED AND SWORN TO BEFORE ME, A NOTARY PUBLIC WITHIN AND FOR SEDGWICK COUNTY, KANSAS, THIS 1ST DAY OF JULY, 1957.

Hazel Pierson
HAZEL PIERSON, NOTARY PUBLIC

MY COMMISSION EXPIRES JULY 2, 1958



07-08-1957

PLUGGING
SEC. 13, T. 10 R. 29W
BOOK PAGE 24 LINE 1