

CARD MUST BE TYPED

# State of Kansas NOTICE OF INTENTION TO DRILL

CARD MUST BE SIGNED

(see rules on reverse side)

Starting Date: 9 15 84  
month day year 125

API Number 15-179-20,765-00-00  
200' N of  
SE SE SW Sec 15 Twp 10S Rge 28W  East  
(location)  West

OPERATOR: License # 5140  
Name Frontier Oil Company  
Address 1720 Kansas State Bk Bldg.  
City/State/Zip Wichita, Kansas 67202  
Contact Person George A. Angle  
Phone 316-263-1201

530 Ft North from Southeast Corner of Section  
2970 Ft West from Southeast Corner of Section  
(Note: Locate well on Section Plat on reverse side)

CONTRACTOR: License # 5302  
Name Red Tiger Drilling Co.  
City/State Wichita, Kansas 67202

Nearest lease or unit boundary line 530 feet.  
County Sheridan  
Lease Name Bieker Well# 1

Well Drilled For: Well Class: Type Equipment:  
 Oil  Swd  Infield  Mud Rotary  
 Gas  Inj  Pool Est.  Air Rotary  
 OWWO  Expl  Wildcat  Cable

Domestic well within 330 feet:  yes  no  
Municipal well within one mile:  yes  no

If OWWO: old well info as follows:

Operator  
Well Name  
Comp Date Old Total Depth  
Projected Total Depth 4100 feet  
Projected Formation at TD Base Kansas City  
Expected Producing Formations Base Kansas City

60' - 90' total depth  
Depth to Bottom of fresh water feet \*\*  
Lowest usable water formation Alluvium Dakota  
Depth to Bottom of usable water Est. 125' 1900 feet  
Surface pipe by Alternate: 1  2   
Surface pipe to be set 200 feet  
Conductor pipe if any required N/A feet  
Ground surface elevation 2715 feet MSL  
This Authorization Expires 3-13-85  
Approved By 9-13-84

I certify that we will comply with K.S.A. 55-101, et seq., plus eventual drilling hole to K.C.C. notification

\*\*See Back of Card

Date 9/13/84 Signature of Operator or Agent

Signature of Operator or Agent  
Title OWNER  
MHC/KOHE 9/13/84  
Form C-1 4/84


\*\*

Must be filed with the K.C.C. five (5) days prior to commencing well  
This card void if drilling not started within six (6) months of date received by K.C.C.

Martin L. Bieker, landowner owns nearest fresh water well 3/4 mile NW of location. Fresh water bottom at 60' TD of fresh water well 90'. Martin L. Bieker knows of now one in this area who now or ever has used the Dakota water.

**Important procedures to follow :**

**A Regular Section of Land**  
**1 Mile = 5,280 Ft.**

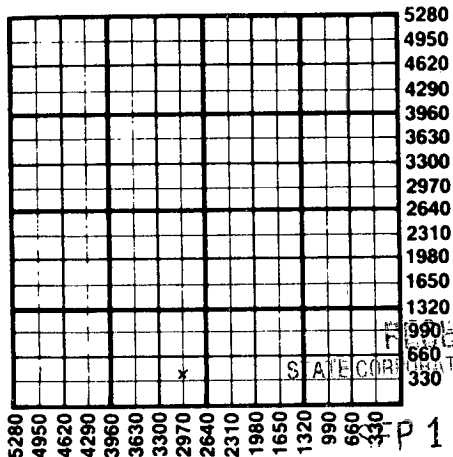

1. Notify District office before setting surface casing.
2. Set surface casing by circulating cement to the top.
3. File completion forms ACO-1 with K.C.C. within 90 days of well completion, following instructions on ACO-1, side 1, and including copies of wireline logs.
4. Notify District office 48 hours prior to old well workover or re-entry.
5. Prior to plugging, prepare a plugging plan, then obtain agreement from the appropriate district office for an approved plugging plan.
6. Submit plugging report (CP-4) to K.C.C. after plugging is completed.
7. Obtain an approved injection docket number before disposing of salt water.
8. Notify K.C.C. within 10 days when injection commences or terminates.

an alternate 2 completion, cement in the production pipe from below any usable water to surface within 120 days of spud date.

RECEIVED  
STATE CORPORATION COMMISSION

SEP 13 1984  
09-13-1984  
Wichita, Kansas

State Corporation Commission of Kansas  
Conservation Division  
200 Colorado Derby Building  
Wichita, Kansas 67202  
(316) 263-3238