

CARD MUST BE TYPED

State of Kansas
NOTICE OF INTENTION TO DRILL
(see rules on reverse side)

CARD MUST BE SIGNED

Starting Date: 11 23 84
month day year

API Number 15- 179-20,778-00-00

OPERATOR: License # 4022
Name Vincent J. Duncan
Address 600 17th St., Suite 2300 South
City/State/Zip Denver, CO 80202
Contact Person Paul Cella
Phone 303-623-4158

NW.. NW.. NW Sec 14.. Twp 10... S, Rge 29.. East
(location) 4950 West
4950 Ft North from Southeast Corner of Section
Ft West from Southeast Corner of Section
(Note: Locate well on Section Plat on reverse side)

CONTRACTOR: License # 6033
Name Murfin Drilling Company
City/State Wichita, KS

Nearest lease or unit boundary line 330 feet.
County Sheridan
Lease Name Stewart Well# 14-1
Domestic well within 330 feet: yes no
Municipal well within one mile: yes no

Well Drilled For: Well Class: Type Equipment:
 Oil Swd Infield Mud Rotary
 Gas Inj Pool Ext. Air Rotary
 OWWO Expl Wildcat Cable

Depth to Bottom of fresh water 200 feet
Lowest usable water formation Dakota
Depth to Bottom of usable water 1400-500 feet
Surface pipe by Alternate: 1 2
Surface pipe to be set 250 feet
Conductor pipe if any required N/A feet
Ground surface elevation --- feet MSL
This Authorization Expires 5-14-85
Approved By 11-14-84 [Signature]

If OWWO: old well info as follows:
Operator
Well Name
Comp Date Old Total Depth
Projected Total Depth 4200 feet
Projected Formation at TD BKC
Expected Producing Formations LKC

I certify that we will comply with K.S.A. 55-101, et seq., plus eventually plugging hole to K.C.C. specifications.

Date 11-14-84 Signature of Operator or Agent

[Signature] Title Ass't. Drilling Manager
MHC/KOHE 11/14/84
Jack E. Goss, Agent for Operator


Must be filed with the K.C.C. five (5) days prior to commencing well
This card void if drilling not started within six (6) months of date received by K.C.C.

RECEIVED
STATE CORPORATION

NOV 14 1984 11-14-1984

Important procedures to follow:

CONSERVATION DIVISION
A Regular Section of Land
Wichita, Kansas
1 Mile = 5,280 Ft.

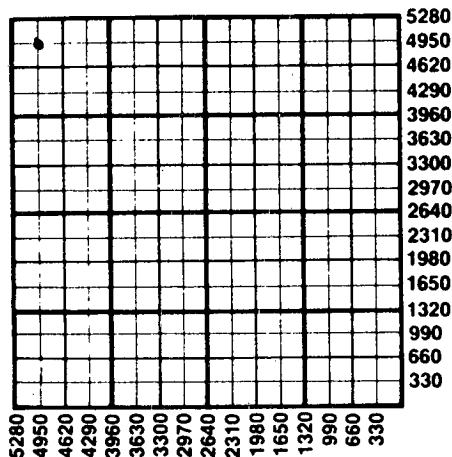

1. Notify District office before setting surface casing.
2. Set surface casing by circulating cement to the top.
3. File completion forms ACO-1 with K.C.C. within 90 days of well completion, following instructions on ACO-1, side 1, and including copies of wireline logs.
4. Notify District office 48 hours prior to old well workover or re-entry.
5. Prior to plugging, prepare a plugging plan, then obtain agreement from the appropriate district office for an approved plugging plan.
6. Submit plugging report (CP-4) to K.C.C. after plugging is completed.
7. Obtain an approved injection docket number before disposing of salt water.
8. Notify K.C.C. within 10 days when injection commences or terminates.
9. If an alternate 2 completion, cement in the production pipe from below any usable water to surface within 120 days of spud date.

State Corporation Commission of Kansas
Conservation Division
200 Colorado Derby Building
Wichita, Kansas 67202
(316) 263-3238