

CARD MUST BE TYPED

State of Kansas

CARD MUST BE SIGNED

NOTICE OF INTENTION TO DRILL

(see rules on reverse side)

Starting Date 1 23 86
month day year 10:31

API Number 15- 179-20,860-00-00

OPERATOR: License # 5140

NE NW SW Sec. 3 Twp. 10 S, Rg. 29 X East West

Name Frontier Oil Company

2310 Ft. from South Line of Section

Address 1720 Kansas State Bk Bldg.

4290 Ft. from East Line of Section

City/State/Zip Wichita, Kansas 67202

(Note: Locate well on Section Plat on reverse side)

Contact Person George A. Angle

Nearest lease or unit boundary line 990 feet

Phone 316-263-1201

County Sheridan

CONTRACTOR: License # 5302

Lease Name Krannawitter Well # 1

Name Red Tiger Drilling Company

Ground surface elevation feet MSL

City/State Wichita, Kansas 67202

Domestic well within 330 feet: yes X no

Well Drilled For: Well Class: Type Equipment:

Municipal well within one mile: yes X no

X Oil SWD Infield X Mud Rotary

Depth to bottom of fresh water 200

Gas Inj X Pool Ext. Air Rotary

Depth to bottom of usable water 1550

OWWO Expl Wildcat Cable

Surface pipe by Alternate: 1 2 X

If OWWO: old well info as follows:

Surface pipe planned to be set 250

Operator

Conductor pipe required N/A

Well Name

Projected Total Depth 4400 feet

Comp Date Old Total Depth

Formation Miss

I certify that well will comply with K.S.A. 55-101, et seq., plus eventually plugging hole to KCC specifications.

Date 1/21/86 Signature of Operator or Agent George A. Angle Title Owner

For KCC Use:

Conductor Pipe Required feet; Minimum Surface Pipe Required 250 feet per Alt. 1 2


This Authorization Expires 7-21-86 Approved By 1-21-86

Must be filed with the K.C.C. five (5) days prior to commencing well
This card void if drilling not started within six (6) months of date received by K.C.C.

Important procedures to follow:

1. Notify District office before setting surface casing.
2. Set surface casing by circulating cement to the top.
3. File completion forms ACO-1 with K.C.C. within 90 days of well completion, following instructions on ACO-1, side 1, and including copies of wireline logs.
4. Notify District office 48 hours prior to old well workover or re-entry.
5. Prior to filing Intent, prepare a proposed plugging plan in case well is D & A, then obtain approval of plan when calling district office prior to setting surface pipe.
6. Submit plugging report (CP-4) to K.C.C. after plugging is completed.
7. Obtain an approved injection docket number before disposing of salt water.
8. Notify K.C.C. within 10 days when injection commences or terminates.
9. If an alternate 2 completion, cement in the production pipe from below any usable water to surface within 120 days of spud date.

A Regular Section of Land
1 Mile = 5,280 Ft.

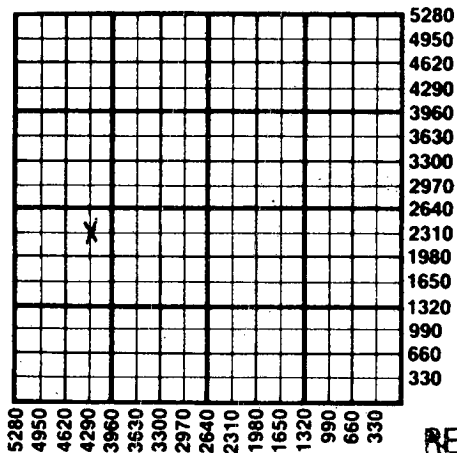

RECEIVED
STATE CORPORATION COMMISSION

JAN 21 1986
01-21-1986
CONSERVATION DIVISION
Wichita, Kansas

State Corporation Commission of Kansas
Conservation Division
200 Colorado Derby Building
Wichita, Kansas 67202
(316) 263-3238