

NOTICE OF INTENTION TO DRILL

(see rules on reverse side)

Starting Date 9 20 85 month day year

API Number 15-065-22,235-00-00

OPERATOR: License # 5886
Name Chief Drilling Co., Inc.
Address 905 Century Plaza Building
City/State/Zip Wichita, Kansas 67202
Contact Person Douglas W. Thimesch
Phone 316-262-3791

NW SE NE Sec. 35 Twp. 10 S, Rg 25 East
3630 Ft. from South Line of Section
990 Ft. from East Line of Section

(Note: Locate well on Section Plat on reverse side)

CONTRACTOR: License # 5422
Name Ambercrombie Drilling Inc.
City/State Wichita, Kansas

Nearest lease or unit boundary line 990 feet
County Graham

Lease Name Knoll Well # 1
Ground surface elevation 2466 feet MSL

Well Drilled For: Well Class: Type Equipment:
[X] Oil [ ] SWD [ ] Infield [X] Mud Rotary
[ ] Gas [ ] Inj [ ] Pool Ext. [ ] Air Rotary
[ ] OWWO [ ] Expl [X] Wildcat [ ] Cable

Domestic well within 330 feet: [ ] yes [X] no
Municipal well within one mile: [ ] yes [X] no
Surface pipe by Alternate: 1 [ ] 2 [X]
Depth to bottom of fresh water 130'
Depth to bottom of usable water 1300'
Surface pipe planned to be set 250'
Projected Total Depth 4100'
Formation Lansing

If OWWO: old well info as follows:

Operator
Well Name
Comp Date Old Total Depth

I certify that well will comply with K.S.A. 55-101, et seq., plus eventually plugging hole to KCC specifications.

Alternate cementing will be done immediately upon setting production casing.
Date 9/2/85 Signature of Operator or Agent Title V.P. Exp.

RCH FOR KONE

For KCC Use:


Conductor Pipe Required feet; Minimum Surface Pipe Required feet per Alt. 1 2
This Authorization Expires 3-9-86 Approved By 9-9-85

Must be filed with the K.C.C. five (5) days prior to commencing well  
This card void if drilling not started within six (6) months of date received by K.C.C.

### Important procedures to follow:

1. Notify District office before setting surface casing.
2. Set surface casing by circulating cement to the top.
3. File completion forms ACO-1 with K.C.C. within 90 days of well completion, following instructions on ACO-1, side 1, and including copies of wireline logs.
4. Notify District office 48 hours prior to old well workover or re-entry.
5. Prior to filing Intent, prepare a proposed plugging plan in case well is D & A, then obtain approval of plan when calling district office prior to setting surface pipe.
6. Submit plugging report (CP-4) to K.C.C. after plugging is completed.
7. Obtain an approved injection docket number before disposing of salt water.
8. Notify K.C.C. within 10 days when injection commences or terminates.
9. If an alternate 2 completion, cement in the production pipe from below any usable water to surface within 120 days of spud date.

### A Regular Section of Land 1 Mile = 5,280 Ft.

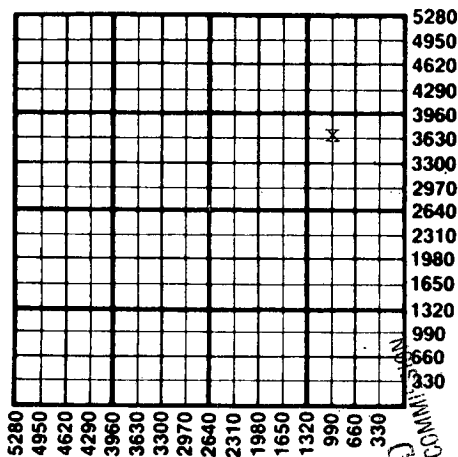

RECEIVED  
CONSERVATION DIVISION  
Wichita, Kansas  
6 PMS  
1091  
58-60-05

State Corporation Commission of Kansas  
Conservation Division  
200 Colorado Derby Building  
Wichita, Kansas 67202  
(316) 263-3238