

15-179-20374-00-00

STATE OF KANSAS
STATE CORPORATION COMMISSION

Form CP-4

Give All Information Completely
Make Required Affidavit
Mail or Deliver Report to:
Conservation Division
State Corporation Commission
P. O. Box 17027
Wichita, Kansas 67217
NORTH

WELL PLUGGING RECORD

Sheridan County, Sec. 15 Twp. 10S Rge. (E)30 (W)
Location as "NE/CNW/SW" or footage from lines C NW SE
Lease Owner F & M Oil Company
Lease Name Hecht Well No. 1
Office Address 603 Union Center, Wichita, Kansas 67202
Character of Well (completed as Oil, Gas or Dry Hole) Dry Hole
Date well completed 3-6-74 19
Application for plugging filed 3-6-74 19
Application for plugging approved 3-6-74 19
Plugging commenced 3-7-74 19
Plugging completed 3-7-74 19
Reason for abandonment of well or producing formation Dry Hole

If a producing well is abandoned, date of last production _____ 19____
Was permission obtained from the Conservation Division or its agents before plugging was commenced? Yes

Name of Conservation Agent who supervised plugging of this well Bill Nichols, Moreland, Ks.
Producing formation _____ Depth to top _____ Bottom _____ Total Depth of Well 4570 Feet
Show depth and thickness of all water, oil and gas formations.

OIL, GAS OR WATER RECORDS

CASING RECORD

FORMATION	CONTENT	FROM	TO	SIZE	PUT IN	PULLED OUT
				8 5/8"	298'	None

Describe in detail the manner in which the well was plugged, indicating where the mud fluid was placed and the method or methods used in introducing it into the hole. If cement or other plugs were used, state the character of same and depth placed, from _____ feet to _____ feet for each plug set.

1st plug @ 1500' w/70 sx
2nd plug @ 310' w/20 sx
3rd plug @ 40' w/10 sx


RECEIVED
STATE CORPORATION COMMISSION
MAR 19 1974
03-19-1974
CONSERVATION DIVISION
Wichita, Kansas

(If additional description is necessary, use BACK of this sheet)
Name of Plugging Contractor Allied Cementing Co., Inc.
Address Box 207, Russell, Kansas

STATE OF Kansas COUNTY OF Sedgwick, ss.
James R. Daniels (employee of owner) or (owner or operator) of the above-described

well, being first duly sworn on oath, says: That I have knowledge of the facts, statements, and matters herein contained and the log of the above-described well as filed and that the same are true and correct. So help me God.

(Signature) James R. Daniels
617 Union Center, Wichita, Kansas 67202
(Address)

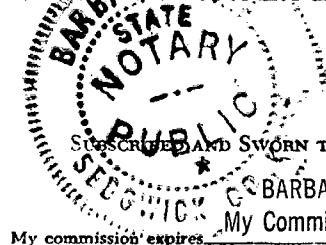

Subscribed and Sworn to before me this 15th day of March, 1974
Barbara Cole
Notary Public.
My commission expires _____

WELL LOG

15-179-20374-00-00

COMPANY F & M Oil Company

SEC. 15 T. 10S R. 30W
LOC. C NW SE

FARM Hecht NO. 1


RIG. NO. 15

TOTAL DEPTH 4570'

COUNTY Sheridan
KANSAS

COMM. 2-23-74

COMP. 3-6-74

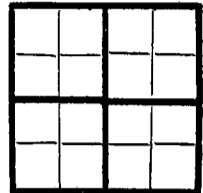

CONTRACTOR Murfin Drilling Company

CASING

20 10
15 8 5/8" @ 298' w/175 sx
12 6
13 5

ELEVATION

PRODUCTION D & A

FIGURES INDICATE BOTTOM OF FORMATIONS

50	Surface soil
240	Sand & shale
1175	Shale
1875	Shale & sand
2456	Shale
2483	Anhydrite
3145	Shale
3540	Shale & lime
4570	Lime
4570	TD

RECEIVED
STATE CORPORATION COMMISSION
MAR 19 1974
03-19-1974
CONSERVATION DIVISION
Wichita, Kansas

State of Kansas
County of Sedgwick } ss:

I, James R. Daniels of the Murfin Drilling Company

upon which state that the above and foregoing is a true and correct copy of the log of the Hecht #1 well.



James R. Daniels

Subscribed and sworn to before me this 15th day of March 1974

BARBARA COLE, Notary Public
My Commission Expires Sept. 5, 1976

Barbara Cole
NOTARY PUBLIC