

STATE OF KANSAS
STATE CORPORATION COMMISSION


Give All Information Completely
Make Required Affidavit
Mail or Deliver Report to:
Conservation Division
State Corporation Commission
211 No. Broadway
Wichita, Kansas

15-065-00483-00-00

WELL PLUGGING RECORD

Graham County County. Sec. 23 Twp. 9S Rge. 23W (E) (W)

Location as "NE/CNW/SW" or footage from lines NE NE NE
Lease Owner Burch drilling Co., Inc.
Lease Name Denning Well No. 1
Office Address 1011 Union Center, Wichita, Kansas
Character of Well (completed as Oil, Gas or Dry Hole) Dry Hole
Date well completed 10-18-58 19
Application for plugging filed 10-18-58 19
Application for plugging approved 10-18-58 19
Plugging commenced 10-18-58 19
Plugging completed 10-18-58 19
Reason for abandonment of well or producing formation Dry Hole

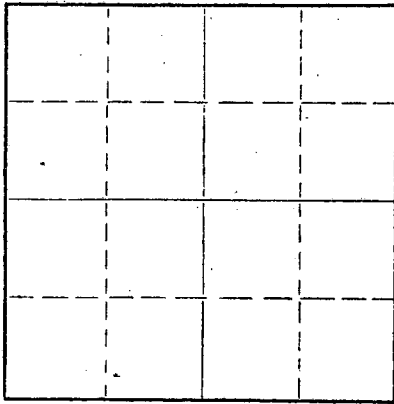

Locate well correctly on above Section Plat

If a producing well is abandoned, date of last production 19
Was permission obtained from the Conservation Division or its agents before plugging was commenced? yes

Name of Conservation Agent who supervised plugging of this well A. D. Fabricius
Producing formation Depth to top Bottom Total Depth of Well 3891' Feet
Show depth and thickness of all water, oil and gas formations.

OIL, GAS OR WATER RECORDS

CASING RECORD

FORMATION	CONTENT	FROM	TO	SIZE	PUT IN	PULLED OUT

Describe in detail the manner in which the well was plugged, indicating where the mud fluid was placed and the method or methods used in introducing it into the hole. If cement or other plugs were used, state the character of same and depth placed, from feet to feet for each plug set.


1st plug set @ 600' with 20 sacks cement
2nd plug set @ 225' with 20 sacks cement
3rd plug set @ 40' with 10 sacks cement

RECEIVED
STATE CORPORATION COMMISSION
NOV 8 1958
CONSERVATION DIVISION
Wichita, Kansas

(If additional description is necessary, use BACK of this sheet)
Name of Plugging Contractor Burch Drilling Co., Inc.
Address 1011 Union Center, Wichita, Kansas

STATE OF KANSAS, COUNTY OF SEDGWICK, ss.
Earl M. Burch, (owner or operator) of the above-described well, being first duly sworn on oath, says: That I have knowledge of the facts, statements, and matters herein contained and the log of the above-described well as filed and that the same are true and correct. So help me God.

(Signature) Earl M. Burch
President
(Address)

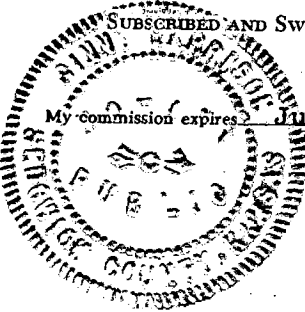

Gerry Harrison
Notary Public.

PLUGGING
FILE SEC 23 T 9 R23W
BOOK PAGE 139 LINE 13

WELL LOG

Burch Drilling Co., Inc.
 # 1 DENNING
 NW NW NW, 23-9S-23W'
 Graham County, Kansas

8 5/8" set @ 225' w/ 160 sx.
 ELEVATION: 2347 Kelly Bushing
 COMM: 10-10-58
 COMP: 10-18-58
 D & A

1200 Shale & Shells
 1910 Shale
 1964 Anhydrite
 2150 Shale
 3652 Shale & Lime
 3890 Lime

 3890 TD

	<u>Top</u>
ANHYDRITE	1931
HEENBER	3616
TORONTO	3641
LANSING	3653

DST # 1 3680-3695 Open 1 hr.
 Rec. 35' Mud. IBHP 30 Min. 1450#,
 IFP 0 FFP 0, FBHP (30 Min.) 1110#.

DST # 2 3695-3710 Tool failed

DST # 3 3695-3710 Open 30 min.
 REC. 10' Mud. No IBHP taken,
 IFP 0 FFP 0, FBHP (30 Min.) 280#.

DST # 4 3730-3742 Open 1 hr.
 Rec. 50' Muddy saltwater, IBHP
 (30 Min.) 1100#, IFP 0#, FFP 0,
 FBHP 1030#.

DST # 5 3782-3800 Open 30 min.
 Rec. 10' mud. IBHP 30 Min. 180#,
 IBP 0, FFP 0, FBHP 30 min. 0#.

DST # 6 3800-3835 Open 30 min.
 REC. 20' mud/ IBHP 30 Min. 1160#,
 IFP 0, FFP 0, FBHP 30 min. 500#.

STATE OF KANSAS, COUNTY OF SEDGWICK:

I, Earl M. Burch, President of Burch Drilling Co., Inc. being duly sworn on oath, state: That I have knowledge of the facts statements and matters herein contained and that the same are true and correct.

Earl M. Burch

Subscribed and sworn to before me this 7th day of November, 1958.

Ginny Harrison
 Notary Public

My commission expires: July 27, 1960/



STATE OF KANSAS
 NOV 8 1958
 CONSERVATION DIVISION
 Wichita, Kansas

PLUGGING
 FILE SEC. 23 T. 9 R. 23W
 BOOK PAGE 139 LINE 13