


WELL PLUGGING RECORD

Give All Information Completely
Make Required Affidavit
Mail or Deliver Report to:
Conservation Division
State Corporation Commission
800 Biting Building
Wichita, Kansas

NORTH

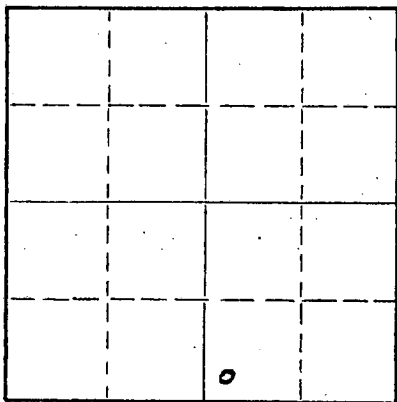

Locate well correctly on above
Section Plat

Graham County, Sec. 23 Twp. 9 Rge. 23 (E) W (W)
Location as "NE/CNW&SW" or footage from lines SW SW SE
Lease Owner E. K. Carey Drilling Co., Inc.
Lease Name Denning Well No. 1
Office Address Box 620, McPherson, Kansas
Character of Well (completed as Oil, Gas or Dry Hole) Dry
Date well completed March 5, 1955 19
Application for plugging filed March 4, " 19
Application for plugging approved March 4, " 19
Plugging commenced 9 A.M. March 5, " 19
Plugging completed 10:15 P.M. March 5, " 19
Reason for abandonment of well or producing formation Dry

If a producing well is abandoned, date of last production _____ 19____
Was permission obtained from the Conservation Division or its agents before plugging was commenced? Yes

Name of Conservation Agent who supervised plugging of this well Mr. Eldon Petty, Hayes, Kansas
Producing formation _____ Depth to top _____ Bottom _____ Total Depth of Well 4228 Feet
Show depth and thickness of all water, oil and gas formations.

OIL, GAS OR WATER RECORDS

CASING RECORD

FORMATION	CONTENT	FROM	TO	SIZE	PUT IN	PULLED OUT
				8-5/8	192	None

Describe in detail the manner in which the well was plugged, indicating where the mud fluid was placed and the method or methods used in introducing it into the hole. If cement or other plugs were used, state the character of same and depth placed, from 185-140 feet to 40-10 feet for each plug set.

Circulated heavy mud on bottom, layed down half of drill pipe.
Circulated heavy mud and layed down rest of drill pipe. Ran measuring line and filled hole with heavy mud to 185', made bridge with wooden block and 1/2 sack hulls, then rock to hold weight of 7 joints drill pipe, mixed 15 sacks cement and put on that bridge, ran measuring line and filled with heavy mud to 40'. Put bridge there with 1/2 sack hulls and mixed 10 sacks cement and put there and filled to bottom of cellar floor.

RECEIVED
STATE CORPORATION COMMISSION
WICHITA, KANSAS
MARCH 1955
CONSERVATION DIVISION
WICHITA, KANSAS


3-8-55

(If additional description is necessary, use BACK of this sheet)
Name of Plugging Contractor E. K. Carey, Drilling Co., Inc.
Address Box 620, McPherson, Kansas

STATE OF Kansas COUNTY OF McPherson, ss.
Arland Bruce (employee of owner) or (owner or operator) of the above-described well, being first duly sworn on oath, says: That I have knowledge of the facts, statements, and matters herein contained and the log of the above-described well as filed and that the same are true and correct. So help me God.

(Signature) Arland Bruce
Box 620, McPherson, Kansas
(Address)

SUBSCRIBED AND SWORN TO before me this 7th day of March, 19 55
Notary Public.

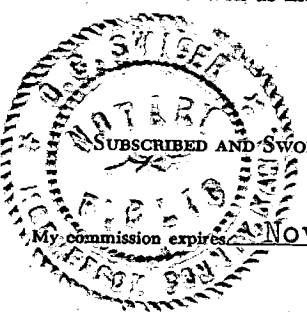

PLUGGING
FILE SEC 22 T 9 R 23W
BOOK PAGE 101 LINE 45

ROTARY DRILLER'S LOG

E. K. Carey Drilling Co., Inc.
Box 620
McPherson, Kansas

2403 KB
Elevations: 2400 DF
2397 Gr.

Donning #1

Casing Record:

Sec. SW SE
Sec. 23-9-23W
Graham County, Kansas

8-5/8" ϕ 192' w/100 sks.
Reg. cement and 100% cc.

Well Commenced: 2-21-55
Well Completed: 3-6-55 D & A

Contractor: E. K. Carey Contractor, Rig #1, Box 620, McPherson, Kansas
Geologist: Don Hollar, E. K. Carey Drlg. Co. 815 Central Bldg. Wichita

Figures Indicate Bottom of Formation K. B.

Cellar	7
Shale and shells	70
Sand	105
Shale and lime	102
Shale and shells	725
Shale, shells and sand	1350
Shale and shells	1525
Sand	1700
Shale and shells	2000
Anhydrite	2035
Shale and shells	2170
Shale and lime	2320
Lime and shale	2765
Lime	3250
Sand and shale	3310
Lime and shale	3450
Lime	3690
Brown lime	3709
K. C. lime	3740
Lime	3935
Shale	3982
Shale and lime	4030
Lime and shale	4215
Lime	4228 TD

Geologist Tops:	
Heebner	3676
Tor.	3696
Lansing	3709
Base K.C.	3935
Warmton Chert	4027
Cherty Congl.	4132
Simpson	4200
Arbuckle	4215
Rotary Total Depth	4228

EST - 3702 - 3765 or 63' anchor.
Tool open 1 hr & 10 min. Closed
20 min. for HEP. Recovered 90'
salt water. TWP 1120% FFP 70%
IFP zero.

3-255

This is to certify that the above information is to the best of my knowledge true and correct.

SUBSCRIBED AND SWORN to before me this 7th day of March, 1955

E. K. CAREY CONTRACTOR

BY Herbert Rhoton
Herbert Rhoton, Superintendent

Co. H. H. H.

MP

My Commission Expires: November 13, 1956

