

CARD MUST BE TYPED

State of Kansas
NOTICE OF INTENTION TO DRILL

CARD MUST BE SIGNED

(see rules on reverse side)

Starting Date: January 12 1985
month day year

API Number 15- 179-20,797-00-00

OPERATOR: License # 9835

SE SW NW (location) Sec 18 Twp 10 S, Rge 26 East West

Name L.B. Petroleum, Inc.

Address 370 17th Street, Suite 3200, Box 47

City/State/Zip Denver, CO 80202

Contact Person Leo R. Schueler

Phone (303) 629-1447

2970 Ft North from Southeast Corner of Section
4290 Ft West from Southeast Corner of Section
(Note: Locate well on Section Plat on reverse side)

CONTRACTOR: License # 5883

Name Warrior Drilling, Inc.

City/State Wichita, KS

Nearest lease or unit boundary line 330 feet.

County Sheridan

Lease Name Flora Well# 18-5

Domestic well within 330 feet: yes no

Municipal well within one mile: yes no

Well Drilled For: Well Class: Type Equipment:

- Oil Swd Infield Mud Rotary
- Gas Inj Pool Ext. Air Rotary
- OWWO Expl Wildcat Cable

Depth to Bottom of fresh water 100 feet

Lowest usable water formation Dakota

Depth to Bottom of usable water 1300 feet

Surface pipe by Alternate: 1 2

Surface pipe to be set 280 feet

Conductor pipe if any required N/A feet

Ground surface elevation 2630' Est. feet MSL

If OWWO: old well info as follows:

Operator

Well Name

Comp Date Old Total Depth

Projected Total Depth 4500 feet

Projected Formation-at-TD

Expected Producing Formations

This Authorization Expires 7-10-85

Approved By 1-10-85 [Signature]

I certify that we will comply with K.S.A. 55-101, et seq., plus eventually plugging hole to K.C.C. specifications.

Date 1/09/85 Signature of Operator or Agent

[Signature] Title
Leo R. Schueler

Operations Manager

m 14C/40HE 7-10-85 Form C-1 4/84

Must be filed with the K.C.C. five (5) days prior to commencing well
This card void if drilling not started within six (6) months of date received by K.C.C.

CONSERVATION DIVISION
Wichita, Kansas

JAN 10 1985


1-10-85

A Regular Section of Land

1 Mile = 5,280 Ft

RECEIVED

STATE CORPORATION COMMISSION

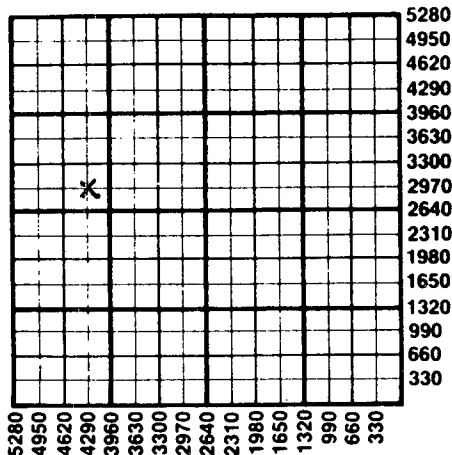

Important procedures to follow :

1. Notify District office before setting surface casing.
2. Set surface casing by circulating cement to the top.
3. File completion forms ACO-1 with K.C.C. within 90 days of well completion, following instructions on ACO-1, side 1, and including copies of wireline logs.
4. Notify District office 48 hours prior to old well workover or re-entry.
5. Prior to plugging, prepare a plugging plan, then obtain agreement from the appropriate district office for an approved plugging plan.
6. Submit plugging report (CP-4) to K.C.C. after plugging is completed.
7. Obtain an approved injection docket number before disposing of salt water.
8. Notify K.C.C. within 10 days when injection commences or terminates.
9. If an alternate 2 completion, cement in the production pipe from below any usable water to surface within 120 days of spud date.

State Corporation Commission of Kansas
Conservation Division
200 Colorado Derby Building
Wichita, Kansas 67202
(316) 263-3238