

CARD MUST BE TYPED

State of Kansas  
**NOTICE OF INTENTION TO DRILL**

CARD MUST BE SIGNED

(see rules on reverse side)

Starting Date: ..... 9-28-85 .....  
month day year

API Number 15- 193-20,368-00-000-239

OPERATOR: License # ..... 5375 .....  
Name Hillenburg Oil Co. .....  
Address ..... 11600 S. Lynn Lane Road .....  
City/State/Zip Broken Arrow, OK 74011 .....  
Contact Person Harold A. Hillenburg, Jr. .....  
Phone ..... 918-455-4444 .....

SE SE SW Sec 12 Twp 10 S, Rge 32  
(location)  East  West

330 ..... Ft North from Southeast Corner of Section  
2970 ..... Ft West from Southeast Corner of Section  
(Note: Locate well on Section Plat on reverse side)

CONTRACTOR: License # ..... 5420 .....  
Name White & Ellis Drilling, Inc. .....  
City/State ..... Wichita, Kansas .....

Nearest lease or unit boundary line ..... 330 ..... feet.  
County ..... Thomas .....  
Lease Name Howard Well# 1

Well Drilled For: Well Class: Type Equipment:  
 Oil  Swd  Infield  Mud Rotary  
 Gas  Inj  Pool Ext.  Air Rotary  
 OWWO  Expl  Wildcat  Cable

Domestic well within 330 feet:  yes  no  
Municipal well within one mile:  yes  no

If OWWO: old well info as follows:  
Operator .....  
Well Name .....  
Comp Date ..... Old Total Depth .....  
Projected Total Depth ..... 5,000 ..... feet  
Projected Formation at TD ..... Arbuckle .....  
Expected Producing Formations ..... Mississippian .....

Depth to Bottom of fresh water ..... 150 200 ..... feet  
Lowest usable water formation ..... Dakota .....  
Depth to Bottom of usable water ..... 250 150 ..... feet  
Surface pipe by Alternate:  1  2  
Surface pipe to be set ..... 200 250 ..... feet  
Conductor pipe if any required ..... ..... feet  
Ground surface elevation ..... 3061 ..... feet MSL  
This Authorization Expires ..... 3-6-86 .....

I certify that we will comply with K.S.A. 55-101, et seq., plus eventually plugging hole to K.C.C. specifications.


Date ..... 9-4-85 ..... Signature of Operator or Agent

*Handwritten Signature: Harold A. Hillenburg*

Approved By ..... 9-6-85 .....  
*Production string will be immediately cemented down below usable water to the surface.*  
Partner *PCN FOR KORE*  
Form C-1 4/84

Must be filed with the K.C.C. five (5) days prior to commencing well  
This card void if drilling not started within six (6) months of date received by K.C.C.

**A Regular Section of Land**  
**1 Mile = 5,280 Ft.**

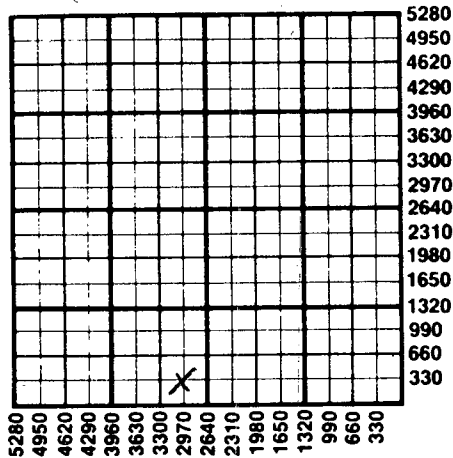

**Important procedures to follow:**

1. Notify District office before setting surface casing.
2. Set surface casing by circulating cement to the top.
3. File completion forms ACO-1 with K.C.C. within 90 days of well completion, following instructions on ACO-1, side 1, and including copies of wireline logs.
4. Notify District office 48 hours prior to old well workover or re-entry.
5. Prior to plugging, prepare a plugging plan, then obtain agreement from the appropriate district office for an approved plugging plan.
6. Submit plugging report (CP-4) to K.C.C. after plugging is completed.
7. Obtain an approved injection docket number before disposing of salt water.
8. Notify K.C.C. within 10 days when injection commences or terminates.
9. If an alternate 2 completion, cement in the production pipe from below any usable water to surface within 120 days of spud date.

RECEIVED  
STATE CORPORATION COMMISSION  
09-06-1985  
SEP 6 1985  
CONSERVATION DIVISION  
Wichita, Kansas

State Corporation Commission of Kansas  
Conservation Division  
200 Colorado Derby Building  
Wichita, Kansas 67202  
(316) 263-3238