

CARD MUST BE TYPED

State of Kansas
NOTICE OF INTENTION TO DRILL
(see rules on reverse side)

CARD MUST BE SIGNED

Starting Date:
month day year

API Number 15- **193-20,353-00-00**
XXXXXXX

OPERATOR: License # **5144**.....

NE SW SE Sec 19 Twp 10S S, Rge 32W West
(location)

Name **MULL DRILLING COMPANY, INC.**.....

Address **P.O. Box 2758**.....

City/State/Zip **Wichita, KS 67201**.....

Contact Person **Patricia Ungleich**.....

Phone **264-6366/264-5368**.....

990 Ft North from Southeast Corner of Section
1650 Ft West from Southeast Corner of Section
(Note: Locate well on Section Plat on reverse side)

CONTRACTOR: License # **6033**.....

Name **Murfin Drilling Company**.....

City/State **250 N Water - Suite 300**.....

Nearest lease or unit boundary line **990'** feet.
County **Thomas**.....
Lease Name **Price 'A'** Well# **#1**.....

Domestic well within 330 feet: yes no
Municipal well within one mile: yes no

Well Drilled For: Well Class: Type Equipment:

- Oil Swd Infield Mud Rotary
- Gas Inj Pool Ext. Air Rotary
- OWWO Expl Wildcat Cable

Depth to Bottom of fresh water **200'** feet
Lowest usable water formation **Dakota**.....
Depth to Bottom of usable water **1725'** feet
Surface pipe by Alternate: ~~1~~ **2**
Surface pipe to be set **8-5/8" @ 360'** feet
Conductor pipe if any required feet
Ground surface elevation feet MSI.
This Authorization Expires **11-9-85**
Approved By **5-9-85** *PC*

If OWWO: old well info as follows:

Operator

Well Name

Comp Date Old Total Depth

Projected Total Depth **4700** feet

Projected Formation at TD **Mississippian**

Expected Producing Formations **Mississippian**

I certify that we will comply with K.S.A. 55-101, et seq., plus eventually plugging hole to K.C.C. specifications.

Date **May 8, 1985** Signature of Operator or Agent

John M. Parker
John M. Parker Title


1007-10 HE 5-9-85

Geologist

Must be filed with the K.C.C. five (5) days prior to commencing well
This card void if drilling not started within six (6) months of date received by K.C.C.

Important procedures to follow :

**A Regular Section of Land
1 Mile = 5,280 Ft.**

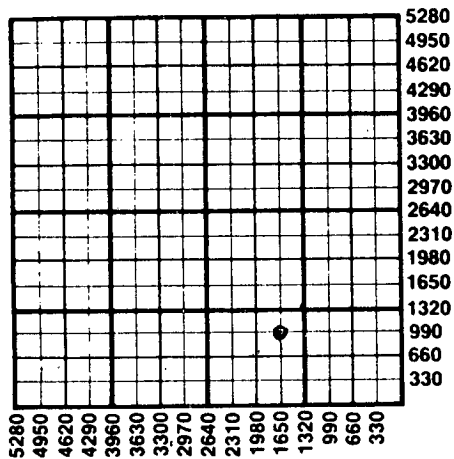

1. Notify District office before setting surface casing.
2. Set surface casing by circulating cement to the top.
3. File completion forms ACO-1 with K.C.C. within 90 days of well completion, following instructions on ACO-1, side 1, and including copies of wireline logs.
4. Notify District office 48 hours prior to old well workover or re-entry.
5. Prior to plugging, prepare a plugging plan, then obtain agreement from the appropriate district office for an approved plugging plan.
6. Submit plugging report (CP-4) to K.C.C. after plugging is completed.
7. Obtain an approved injection docket number before disposing of salt water.
8. Notify K.C.C. within 10 days when injection commences or terminates.
9. If an alternate 2 completion, cement in the production pipe from below any usable water to surface within 120 days of spud date.

RECEIVED

STATE CORPORATION COMMISSION

05-09-1985
MAY 09 1985

State Corporation Commission of Kansas

Conservation Division

200 Colorado Derby Building

Wichita, Kansas 67202

(316) 263-3238

CONSERVATION DIVISION
Wichita, Kansas