

EFFECTIVE DATE:

P.4.

FORM MUST BE TYPED

State of Kansas

FORM MUST BE SIGNED

FORM C-1

EFFECTIVE DATE: 1-27-91

NOTICE OF INTENTION TO DRILL

ALL BLANKS MUST BE FILLED

Must be approved by the K.C.C. five (5) days prior to commencing well

Expected Spud Date 1 28 1991 month day year

SW. SW.. NW.. Sec 1.9.. Twp 1.0.. S, Rg 32.. East West

OPERATOR: License # 4629 Name: Brito Oil Company, Inc. Address: 200 E. First, Suite 208 City/State/Zip: Wichita, KS 67020 Contact Person: Raul F. Brito Phone: 316-263-8787

2970 feet from South line of Section 4950 feet from East line of Section (Note: Locate well on Section Plat on Reverse Side)

CONTRACTOR: License #: 5422 Name: Abercrombie Drilling, Inc.

County: Thomas Lease Name: Soucie Well #: 1-19 Field Name: WC

Well Drilled For: Oil Inj Infield Mud Rotary Gas Storage Pool Ext. Air Rotary OWWO Disposal Wildcat Cable Seismic; # of Holes

Is this a Prorated Field? yes X no Target Formation(s): Lansing, Marmaton, Chero Nearest lease or unit boundary: 330' Ground Surface Elevation: 3101' feet MSL

If OWWO: old well information as follows: Operator: Well Name: Comp. Date: Old Total Depth

Domestic well within 330 feet: yes X no Municipal well within one mile: yes X no Depth to bottom of fresh water: 200' Depth to bottom of usable water: 1900' Surface Pipe by Alternate: 1 X 2 Length of Surface Pipe Planned to be set: 200' Length of Conductor pipe required: None

Directional, Deviated or Horizontal wellbore? yes X no If yes, total depth location:

Projected Total Depth: 4700' Formation at Total Depth: Mississippi Water Source for Drilling Operations: well farm pond X other DWR Permit #: Will Cores Be Taken?: yes X no If yes, proposed zone:

AFFIDAVIT

The undersigned hereby affirms that the drilling, completion and eventual plugging of this well will comply with K.S.A. 55-101, et. seq.

It is agreed that the following minimum requirements will be met:

- 1. The appropriate district office shall be notified before setting surface pipe;
2. The minimum amount of surface pipe as specified above shall be set by circulating cement to the top; in all cases surface pipe shall be set through all unconsolidated materials plus a minimum of 20 feet into the underlying formation;
3. If the well is dry, a plugging proposal shall be submitted to the district office. An agreement between the operator and the district office on plug length and placement is necessary prior to plugging;
4. The appropriate district office will be notified before well is either plugged or production casing is cemented in;
5. If an Alternate II completion, production pipe shall be cemented from below any usable water to surface within 120 days of spud date. In all cases, notify district office prior to any cementing.

I hereby certify that the statements made herein are true and to the best of my knowledge and belief.

Date: 1-27-91 Signature of Operator or Agent: Title: President

FOR KCC USE: API # 15- 193-20,543-00-00 Conductor pipe required None feet Minimum surface pipe required 200 feet per Alt. Approved by: mlu 1-27-91 EFFECTIVE DATE: 1-27-91 This authorization expires: 7-22-91 (This authorization void if drilling not started within 6 months of effective date.) Spud date: Agent:

19 10 32W JAN 22 1991 RECEIVED STATE CONSERVATION DIVISION WICHITA, KANSAS 01-22-1991

REMEMBER TO:

- File Drill Pit Application (form CDP-1) with Intent to Drill;
- File Completion Form ACO-1 within 120 days of spud date;
- File acreage attribution plat according to field proration orders;
- Notify appropriate district office 48 hours prior to workover or re-entry;
- Submit plugging report (CP-4) after plugging is completed;
- Obtain written approval before disposing or injecting salt water.


PLAT OF ACREAGE ATTRIBUTABLE TO A WELL

State Corporation Commission, Conservation Division
 200 Colorado Derby Bldg. Wichita, Kansas 67202

OPERATOR Brito Oil Company, Inc. LOCATION OF WELL:
 LEASE Soucie 2970' feet north of SE corner
 WELL NUMBER #1-19 4950' feet west of SE corner
 FIELD Wildcat Sec. 19 T 10 R 32 NE/W
 COUNTY Thomas
 NO. OF ACRES ATTRIBUTABLE TO WELL 10 IS SECTION X REGULAR IRREGULAR?
 DESCRIPTION OF ACREAGE NE/4 IF IRREGULAR, LOCATE WELL FROM NEAREST
 CORNER BOUNDARY.

NOTE: If plat depicted is insufficient for your circumstances, you may attach your own scaled or surveyed plat.

PLAT

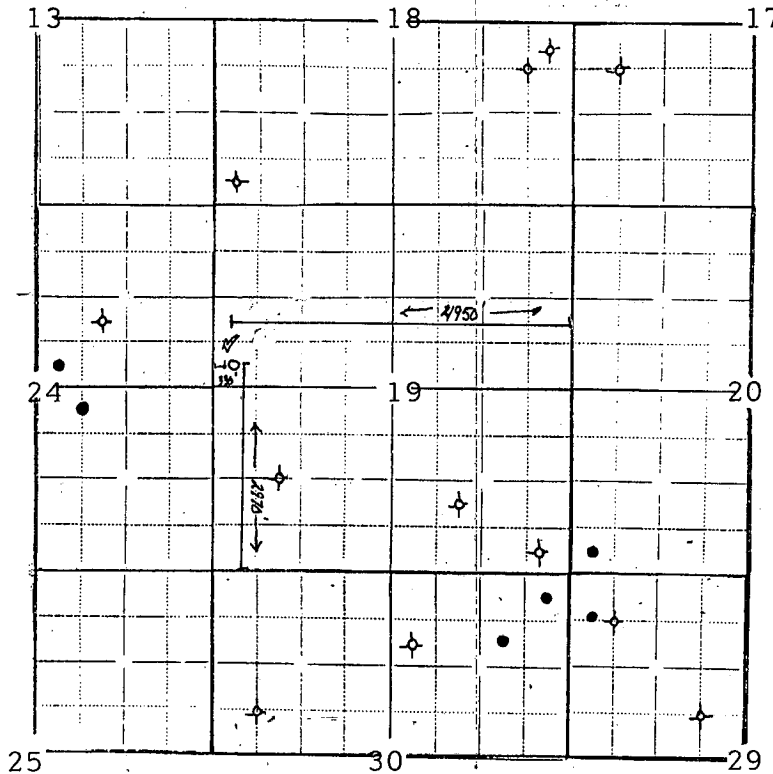

In plotting the proposed location of the well, you must show:

- 1) The manner in which you are using the depicted plat by identifying section lines, i.e. 1 section, 1 section with 8 surrounding partial sections, 4 sections, 16 sections, etc.;
- 2) the well's location relative to the location of other wells producing from the same common source of supply in adjoining drilling units, pursuant to K.A.R. 82-3-108, 82-3-207, 82-3-312, or special orders of the Commission;
- 3) the distance of the proposed drilling location from the section's east and south lines; and
- 4) the distance to the nearest lease or unit boundary line.

I hereby certify that the statements made herein are true and to the best of my knowledge and belief.

Signature of Operator or Agent [Signature]
 Date 1-21-91 Title President

AKM