

CARD MUST BE TYPED

State of Kansas

CARD MUST BE SIGNED

NOTICE OF INTENTION TO DRILL

CORRECTED

COLLECTED 22487

(see rules on reverse side)

Starting Date 3 10 87 month day year

API Number 15-167-22,771-00-00 *250 North & 50 East SW SE SW Sec. 18 Twp. 11 S, Rg. 14 East ** 580 Ft. from South Line of Section ** 3580 Ft. from East Line of Section

OPERATOR: License # 5146 Name Rains & Williamson Oil Co., Inc. Address 435 Page Court, 220 West Douglas City/State/Zip Wichita, Kansas 67202 Contact Person Juanita Green Phone (316) 265-9686

(Note: Locate well on Section Plat on reverse side) Nearest lease or unit boundary line 580 feet County Russell Lease Name CHRISLER-RODA "A" Well # 1

CONTRACTOR: License # 5146 Name Same as Above City/State

Ground surface elevation feet MSL Domestic well within 330 feet: yes no Municipal well within one mile: yes no Depth to bottom of fresh water 75 Depth to bottom of usable water 525 Surface pipe by Alternate: 1 2 X Surface pipe planned to be set 255 Conductor pipe required -0- Projected Total Depth 3450 feet Formation Arbuckle

Well Drilled For: Well Class: Type Equipment: X Oil SWD Infield X Mud Rotary X Gas Inj Pool Ext Air Rotary OWWO Expl Wildcat Cable

If OWWO: old well info as follows: Operator Well Name Comp Date Old Total Depth

I certify that well will comply with K.S.A. 55-101, et seq., plus eventually plugging hole to KCC specifications. Date 3-23-87 Signature of Operator or Agent Wilson Rains Title PRESIDENT

For KCC Use: Conductor Pipe Required feet: Minimum Surface Pipe Required 200 feet per Alt. & B This Authorization Expires 9-5-87 Approved By 3-5-87


*spot location was SW SE SW ** was 330 FSL & 3630 FEL

Must be filed with the K.C.C. five (5) days prior to commencing well
This card void if drilling not started within six (6) months of date received by K.C.C.

Important procedures to follow:

1. Notify District office before setting surface casing.
2. Set surface casing by circulating cement to the top.
3. File completion forms ACO-1 with K.C.C. within 90 days of well completion, following instructions on ACO-1, side 1, and including copies of wireline logs.
4. Notify District office 48 hours prior to old well workover or re-entry.
5. Prior to filing Intent, prepare a proposed plugging plan in case well is D & A, then obtain approval of plan when calling district office prior to setting surface pipe.
6. Submit plugging report (CP-4) to K.C.C. after plugging is completed.
7. Obtain an approved injection docket number before disposing of salt water.
8. Notify K.C.C. within 10 days when injection commences or terminates.
9. If an alternate 2 completion, cement in the production pipe from below any usable water to surface within 120 days of spud date.

A Regular Section of Land 1 Mile = 5,280 Ft.

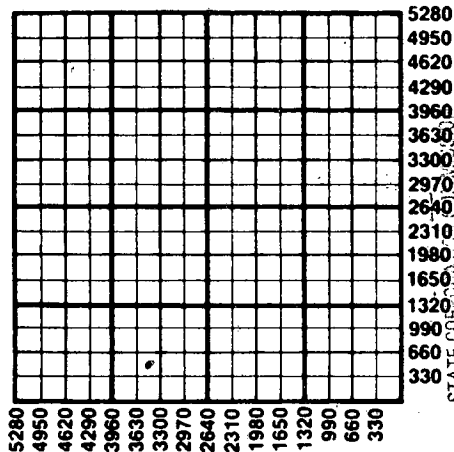

3-24-1987
MAR 24 1987

CONSERVATION DIVISION
Wichita, Kansas

State Corporation Commission of Kansas
Conservation Division
200 Colorado Derby Building
Wichita, Kansas 67202
(316) 263-3238

CARD MUST BE TYPED

State of Kansas

CARD MUST BE SIGNED

NOTICE OF INTENTION TO DRILL

CORRECTED

collected 22487

(see rules on reverse side)

Starting Date 3 10 87 month day year

API Number 15-167-22,771-00-00 *250 North & 50 East

OPERATOR: License # 5146 Name Rains & Williamson Oil Co., Inc. Address 435 Page Court, 220 West Douglas City/State/Zip Wichita, Kansas 67202 Contact Person Juanita Green Phone (316) 265-9686

SW SE SW Sec. 18 Twp. 11 S, Rg. 14 X East ** 580 Ft. from South Line of Section ** 3580 Ft. from East Line of Section

(Note: Locate well on Section Plat on reverse side)

Nearest lease or unit boundary line 580 feet

County Russell

Lease Name CHRISLER-RODA "A" Well # 1

Ground surface elevation feet MSL

Domestic well within 330 feet: yes no

Municipal well within one mile: yes no

Depth to bottom of fresh water 75

Depth to bottom of usable water 525

Surface pipe by Alternate: 1 2 X

Surface pipe planned to be set 255

Conductor pipe required -0-

Projected Total Depth 3450 feet

Formation Arbuckle

CONTRACTOR: License # 5146 Name Same as Above

City/State

Well Drilled For: Well Class: Type Equipment:

X Oil SWD Infield X Mud Rotary X Gas Inj Pool Ext Air Rotary OWWO Expl X Wildcat Cable

If OWWO: old well info as follows:

Operator

Well Name

Comp Date Old Total Depth

I certify that well will comply with K.S.A. 55-101, et seq., plus eventually plugging hole to KCC specifications.

Date 3-23-87 Signature of Operator or Agent Wilson Rains Title PRESIDENT

For KCC Use:

Conductor Pipe Required feet; Minimum Surface Pipe Required 200 feet per Alt. & D

This Authorization Expires 7-5-87 Approved By 3-5-87

*spot location was SW SE SW ** was 330 FSL & 3630 FEL

Melvin White Rains & Williams

Spud 5-25-87 set 225'

hand mpt

SW NW NE Sec. 19 Twp. 11 S, Rg. 14 X East West

PLUGGING PROPOSAL IF ABOVE IS D & A

This plugging proposal will be reviewed and approved or revised at the time the district office is called prior to setting surface casing (call 7 a.m. to 5 p.m. workdays).

Table with 3 columns: Plug depth (feet), Plug depth (feet), and Plug depth (feet) with corresponding 'sxs' values and '6% gel' specifications.

NOTE: Agreement between operator and district office on plug placement and the amount of cement to be used is necessary prior to plugging. In Addition: Call district office after well is either plugged or production casing is cemented in.

MAR 25 1987 (Call 7 a.m. to 5 p.m. workdays)

District office use only:

Hays, KS

API #15- feet set with sxs at hours, 19

Surface casing of feet set with sxs at hours, 19

Alternate 1 or 2 surface pipe was used.

Alternate 2 cementing was completed @ ft. depth with sxs on, 19

Hole plugged, 19, agent

RECEIVED STATE CORPORATION COMMISSION

Form C-1 12/85

JUN 12 1987 6-12-1987 CONSERVATION DIVISION Wichita, Kansas